

# KANSAS


Rice

Section 29 Township 19 Range 9W

Well No. 1 Wallace

Company Geo. Seigrist

Chase  
NORTH

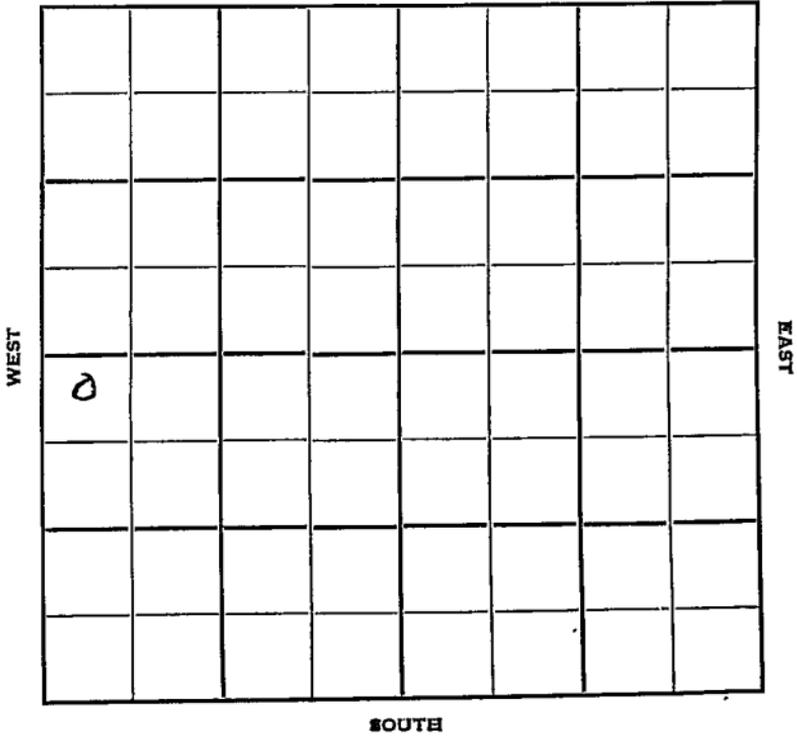

KANSAS

Rice

Sec. 29 Twp. 19 R. 9W

Well No. #1 Wallace Farm

Geo. Seigrist Company

Chase Pool


330' Ft. from N. Line

\_\_\_\_\_ Ft. from S. Line

\_\_\_\_\_ Ft. from E. Line

330'

\_\_\_\_\_ Ft. from W. Line

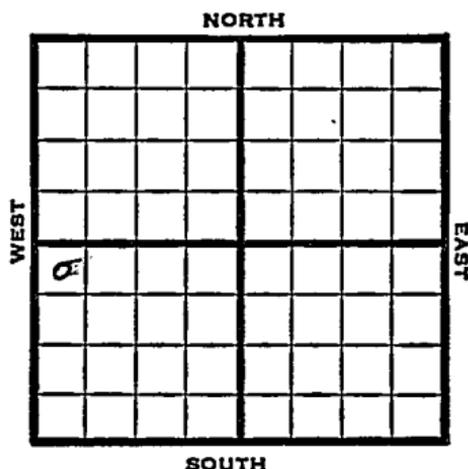

NW SW

1949

Elev 1722'

REPORT

5/4

Surface Hole

5/10

8" @ 150

Drlg 2634'

5/18

Drlg 3026'

5/25

Lans. 2916'

Arb. 3218-24'

TD 3224'

5" @ 3822'

6/1

TD 3229'

Arb. 3218'

5 @ 3222

200 acid

Pump 75 Oil Pot

42° Gr.

Comp

**COMPLETED**

Map No. \_\_\_\_\_ Sec. 29 Twp. 19 R. 9W

Well No. 1 Wallace

Geo. Seigrist Company

**FIRST REPORT** Contractor

NW SW


SECTION PLAT

330 Ft. from N. Line

\_\_\_\_\_ Ft. from S. Line

\_\_\_\_\_ Ft. from E. Line

330 Ft. from W. Line

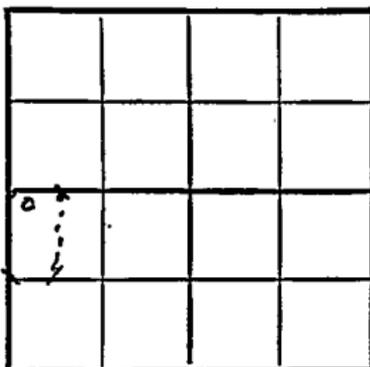

Rice County

Location \_\_\_\_\_

Rig up \_\_\_\_\_

Drilling and Remarks:

surface hole

RECORD

Cased \_\_\_\_\_ in., \_\_\_\_\_ ft.

Sand \_\_\_\_\_

Gas \_\_\_\_\_

Oil \_\_\_\_\_

Total Depth \_\_\_\_\_

PRODUCTION

1st 24 hrs. Nat. \_\_\_\_\_

1st 24 hrs. after shot \_\_\_\_\_

Gas \_\_\_\_\_ Cu. Ft.

Dry Hole \_\_\_\_\_

Abandoned \_\_\_\_\_

Date

MAY 4 1949 19

S. J. LEWIS Scout

Map No. R49 Sec. 29 Twp. 19 R. 9W

Well No. 1 Wallace

Geo. Seigrist Company

**COMPLETE** Contractor

NW SW

*E11722*

**SECTION PLAT**

330 Ft. from N. Line

\_\_\_\_\_ Ft. from S. Line

\_\_\_\_\_ Ft. from E. Line

330 Ft. from W. Line

0			

Rice County

Location \_\_\_\_\_

Rig up \_\_\_\_\_

Drilling and Remarks:

*CR 3218*  
*5" @ 3222*  
*200 acid*  
*Pump 75 oil Rod*  
*H2 2/4*

**RECORD**

Cased \_\_\_\_\_ in., \_\_\_\_\_ ft.

Sand \_\_\_\_\_

Gas \_\_\_\_\_

Oil \_\_\_\_\_

Total Depth 3229

**PRODUCTION**

1st 24 hrs. Nat. \_\_\_\_\_

1st 24 hrs. after shot \_\_\_\_\_

Gas \_\_\_\_\_ Cu. Ft.

Dry Hole \_\_\_\_\_

Abandoned \_\_\_\_\_

Date

JUN 1 1949 19

S. J. LEWIS Scout