


Section 29 Township 19 Range 9-W

Well No. 7 Wallace

Company Sinclair-Prairie

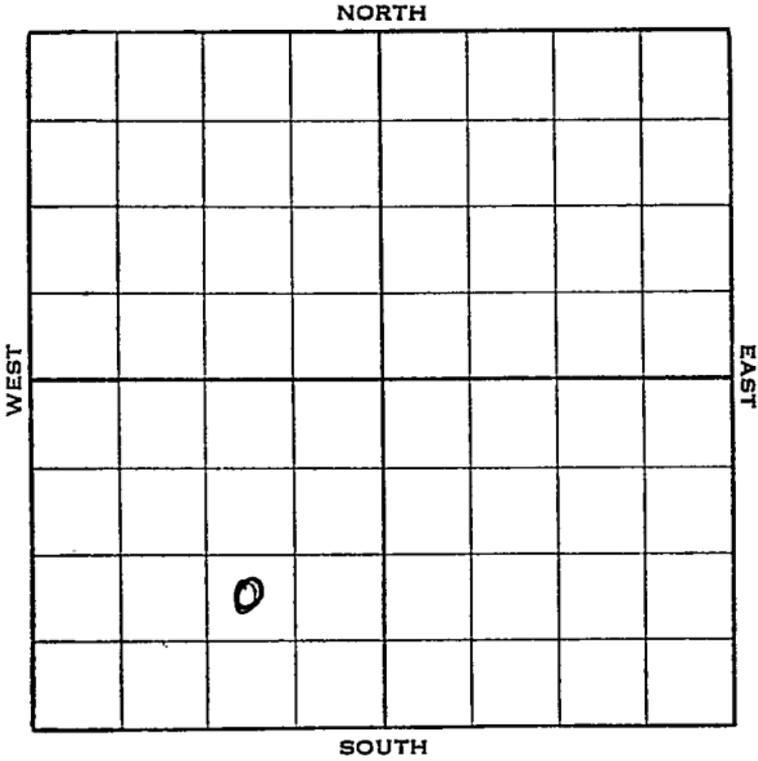

KANSAS - Rice

Sec. 29 Twp. 19 R. 9-W


Well No. #7 Wallace Farm
Sinclair-Prairie Company

_____ Ft. from N. Line

990 Ft. from S. Line

990 Ft. from E. Line

_____ Ft. from W. Line

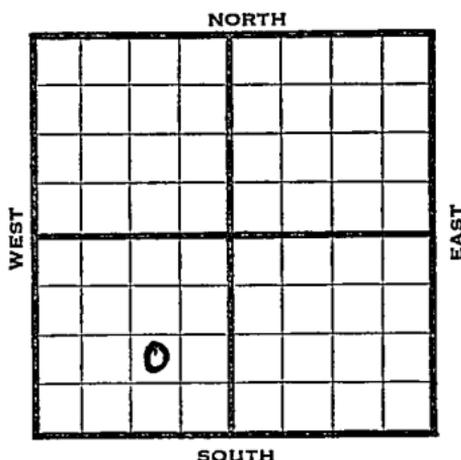

Elev. 1715

REPORT	
1938	
4/6	Location
4/15	Cellar.
4/22	"
4/29	R U R
5/6	8" @ 160'. Drlg. 1245'.
5/12	Drlg. 2178'.
5/20	K.O. 2925'. Drlg. 2985'.
5/27	Arb. 3230-35'. T.D. 3235'. S.O.
	5" @ 3230'. WOC.
6/3	T.D. 3248'. 1000 acid.
6/8	5" @ 3230'.
	Arb. 3230'.
	T.D. 3248'.
	2000 acid.
	15 bbls. (Minimum well)
	COMPLETED

Map No. 49 Sec. 29 Twp. 19 R. 9WWell No. 7 WallaceSinclair Prairie

Company

FIRST REPORT

Contractor

NW SE SW

 Ft. from N. Line990 Ft. from S. Line990 Ft. from E. Line Ft. from W. Line

SECTION PLAT

	0		

Location XRig up

Drilling and Remarks:

RECORD

Cased in., ft.Sand Gas Oil Total Depth

PRODUCTION

1st 24 hrs. Nat. 1st 24 hrs. after shot Gas Cu. Ft.Dry Hole •Abandoned

Date

APR 6 - 1938

19

H. D. Hatfield

Scout

Rice

KANSAS

Map No. 49 Sec. 29 Twp. 19 R. 9WWell No. 7 WallaceSinclair Prairie Company

Contractor

COMPLETED

SECTION PLAT

NW SE SW
 _____ Ft. from N. Line
990 Ft. from S. Line
990 Ft. from E. Line
 _____ Ft. from W. Line

	0		

Location _____

Rig up _____

Drilling and Remarks:

Good Acid15 bblsMINIMUM WELL

RECORD

Cased 5 in., 3230 ft.Sand Arb 3230

Gas _____

Oil _____

Total Depth 3248

PRODUCTION

1st 24 hrs. Nat. _____

1st 24 hrs. after shot _____

Gas _____ Cu. Ft.

Dry Hole _____

Abandoned _____

Date

JUN 8 - 1938 19H. D. Hatfield Scout