


Section 29 Township 19 Range 9W

Well No. #2 Wallace

Company D. B. Q. Oil

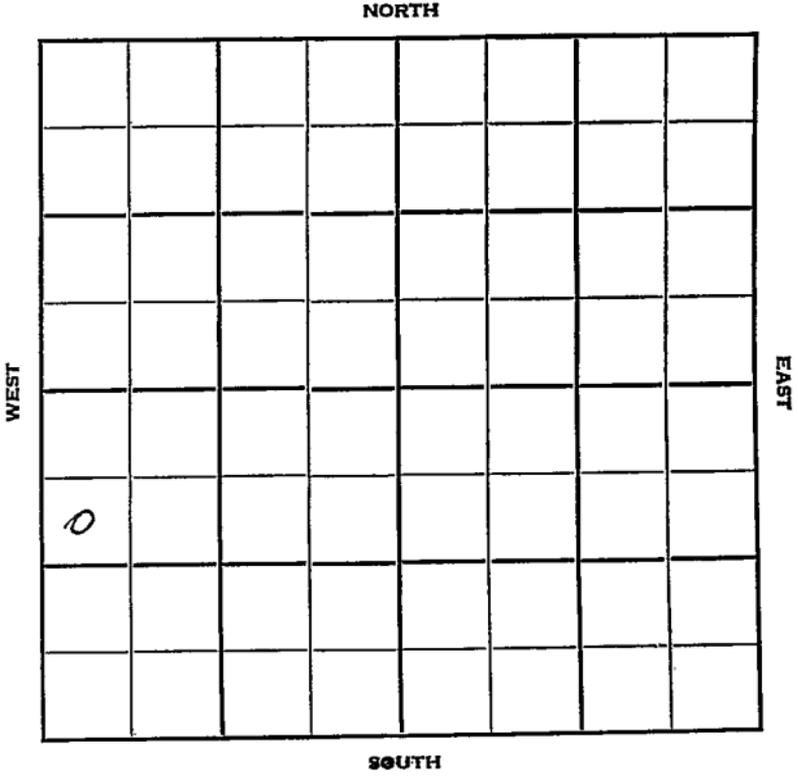

Rice KANSAS

Sec. 29 Twp. 19 R. 9 W ✓

Well No. # 2 Wallace Farm

D. B. Q. Oil Company

Sterling Drlg. Contractor

**Chase Pool**


1090 Ft. from N. Line

\_\_\_\_\_ Ft. from S. Line

\_\_\_\_\_ Ft. from E. Line

380 Ft. from W. Line

SW NW SW

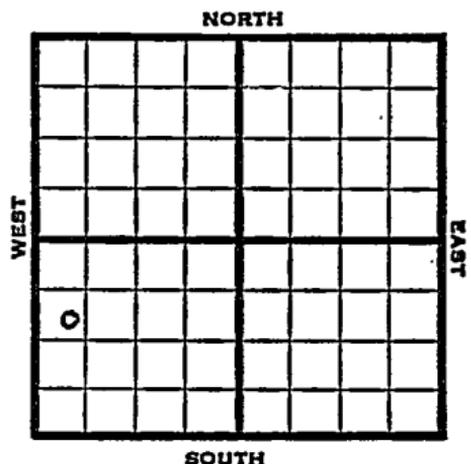

1951

Elev. 1715' REPORT

3/21

Location

6/13

Spud 3-21-51  
 Oil well TD 3231' 8" @ 160  
 Anhy 360' Heeb 2767' Lans. 2915'  
 Cong. 3220' Arb. 3229'  
 TD 3231' 5" @ 3229 S/2½ BOPH  
 500 A  
 Comp. 8 BOPD

**COMPLETED**



