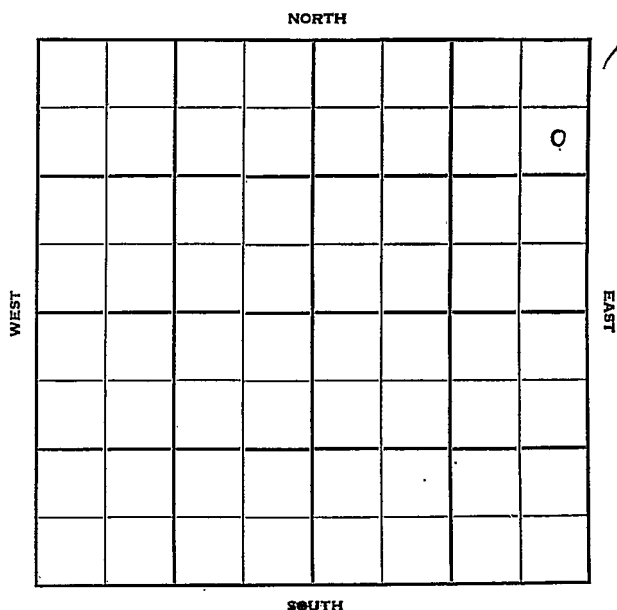


Section 29 Township 19 Range 12 WWell No. # 1 Johnson (D)Company B & R Drig

Barton

KANSAS

Sec. 29 Twp. 19 R. 12W

Well No. #1 Johnson (D) Farm

B & R Drlg. Company

B & R Drlg. - Contr. Contractor


990' Ft. from N. Line

Ft. from S. Line

330' Ft. from E. Line

Ft. from W. Line

SE NE NE

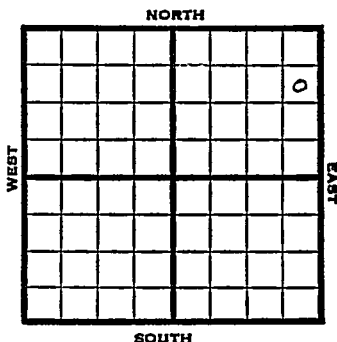

1951 Elev. 1836' REPORT

7/11 RUR

7/25 Spud 7-10-51

D & A TD 3504' 10" @ 115


Anhy 645' Heeb 3148' Br. lime

3166' Lans. 3186' Arb. 3484'

TD 3504' D & A

ABANDONED

J. E. TYRA

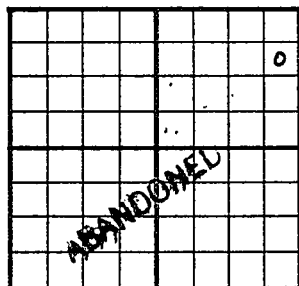County Barton State KansasSec. 29 (Blk. Twp.) 19 (Sur. Rge.) 12W Map No.Operator B & R Drlg.Well No. 1 Farm Johnson "D"Elev. 1836 Location SE NE NE990 Ft. From 'N Line NE330 Ft. From E Line QuarterIst. ReportCompletion JUL 25 1951RemarksB & R Drlg. - Contr.Spudding Date 7-10-51Drlg. Data D & A TD 350410" @ 115 Anhy 645 Heeb. 3148Br. lime 3166 Lans. 3186 Arb. 3484TD 3504 D & A

J. E. TYRA