

Section 29 Township 19 Range 12W

Well No. #1 Johnson "C"

Company V.E. Autry & Phil Davis

NORTH

WEST

EAST

				0			

SOUTH

2

Barton KANSAS

SEC. 29 TWP. 19 R. 12W ✓

WELL NO. 1 Johnson "C" FARM

COMPANY V. E. Autry & Phil Davis

CONTRACTOR H & H Drlg.


Ft. Zarah Pool

330 Ft. from N. Line

Ft. from S. Line

Ft. from E. Line

330 Ft. from W. Line

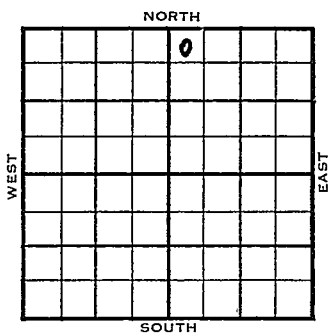

NW NW NE

1954 ELEVATION 1825' REPORT

4/14 Spud 4-10-54  
8" @ 174'  
Anhy 665'  
Drlg. 1678'

4/28 Spud 4-10-54  
D & A  
TD 3427'  
8" @ 174'  
Anhy 665', Heeb 3024', Br. Lime 3137'  
Lans 3152'  
DST 3154'-83' opn 1 hr rec 90' wcm 1070#  
DST 3197'-3228' opn 1/2 hr, rec 15' Mud SSO 250#  
DST 3339'-57' opn 1 hr rec 6' Mud 760# B KC 3397', Arb 3400'  
DST 3403'-13' opn 1/2 hr, rec 10' Mud SSO 230#  
DST 3410'-27' opn 2 hr, rec 60' wtr 180' sul wtr. 750#  
TD 3427'  
D & A

**ABANDONED**



