


Section 29 Township 19 Range 12W

Well No. #1 Wolf

Company Hilton Drlg.

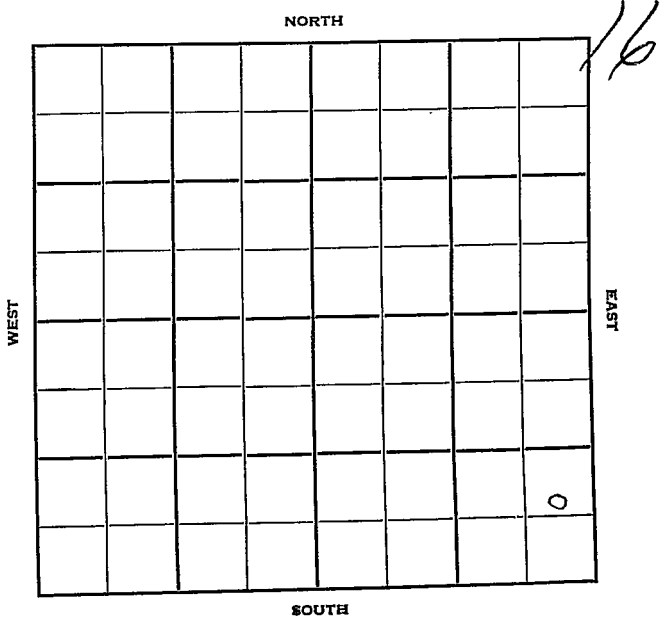

Barton

KANSAS

Sec. 29 Twp. 19 R. 12W

Well No. #1 Wolf Farm

Hilton Drlg. Company


Hilton - Contr. Contractor

Ft. from N. Line

800' Ft. from S. Line

330' Ft. from E. Line

Ft. from W. Line

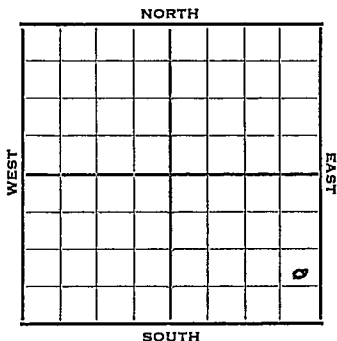

SE NE SE SE

1952 Elev. 1818' REPORT

4/16 Spud 4-10-52
8" @ 155
Anhy 630
Drlg. 1830'

4/23 Heeb. 2983 Br Li 3099
4/30 DST 3347-66, 1 hr. 60 clear oil 60'
oil 880#
Arb. 3371 RTD 3375
5" @ 3372' CO 3275 S&F 30 boph
for 4 hrs.

5/7 NR

5/14 "

5/21 "

5/28 "

6/4 Spud 4-10-52
Oil Well TD 3375 8" @ 155'
Anhy 630 Heeb. 2983
Br Li 3099 Lans. 3113
DST 3347-66 open 1 hr. rec. 60'
clean oil 60' hvy oil
Arb. 3371-75' 5" @ 3372' CO to 3375
S/ & F/ 30 boph Comp. 19 1/4 bopd

COMPLETED

