


Section 29 Township 19 Range 12 W

Well No. # 2 Ariz

Company Lion Oil

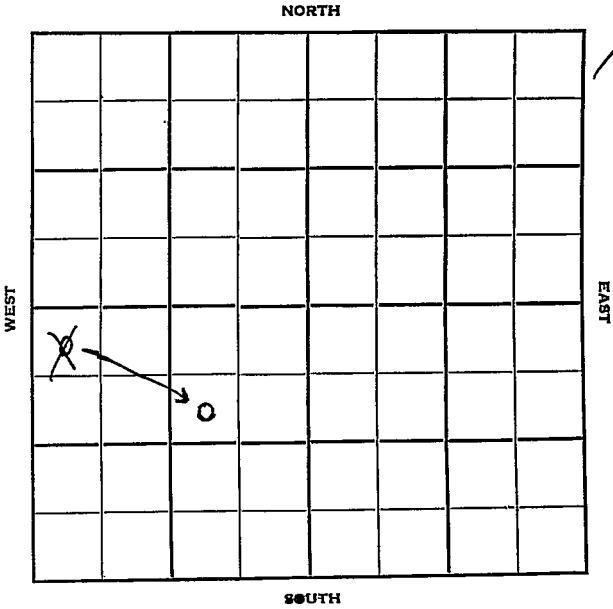

Sec. 29 Twp. 19 R. 12W

Well No. #2 Artz Farm

Lion Oil Company

Rine Drlg. - Contr. Contractor

Ft. Zarah Pool

~~990~~
~~330'~~


Ft. from N. Line

Ft. from S. Line

990 Ft. from E. Line

~~330'~~ Ft. from W. Line

~~NW NW SW~~
SW NE SW

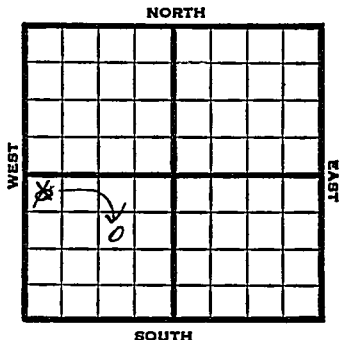

1951 Elev. 1822' REPORT

7/3
10/10

Location
Spud 8-25-51
Oil Well TD 3391
9" @ 235' Br. lime 3106 KC 3119
DST 3124-96 open 5 min. gas in 5
min. Rec. 60' HGCM 240' ho & GCM
120' oil Arb. 3371-75
5" @ 3372 TD 3391 500 A
S/ 6 $\frac{1}{2}$ boph Comp. 198 bopd

COMPLETED

Kansas

Map No. _____ Sec. 29 Twp. 19 R. 12W

Well No. 2 Artz

Lion Oil Company

~~CORRECTION~~ Contractor

SW NE SW

SECTION PLAT

990 Ft. from N. Line

_____ Ft. from S. Line

990 Ft. from E. Line

_____ Ft. from W. Line

	o		

Barton County

Location _____

Rig up _____

Drilling and Remarks:

Reported

NW NW SW

RECORD

Cased _____ in., _____ ft.

Sand _____

Gas _____

Oil _____

Total Depth _____

PRODUCTION

1st 24 hrs. Nat. _____

1st 24 hrs. after shot _____

Gas _____ Cu. Ft.

Dry Hole _____

Abandoned _____

Date

JUL 18 1951

19

J. E. TYRA Scout

County Barton State Kansas

Sec. 29 (Blk. 19) (Sur. 12W) Map No.

Operator Lion Oil

Well No. 2 Farm Artz

Elev. 1822 Location SW NE SW

990 Ft. From N Line SW
 990 Ft. From E Line Quarter

1st. Report

Completion OCT 10 1951

Remarks Ft. Zarah Pool

Rine Drlg. - Contr.

Spudding Date 8-25-51

Drlg. Data Oil well TD 3391

9" @ 235 Br. lime 3106 KC 3119

DST 3124-96 open 5 min. gas in 5 min.

Rec. 60' hgcm 240' ho & gcm 120' oil

Arb. 3371-75 5" @ 3372 TD 3391

500 A S/ 6 1/2 boph Comp. 198 bopd

J. E. TYRA