


Section 29 Township 19 Range 12W

Well No. 2 Scharz

Company Alpine Oil & Derby et al

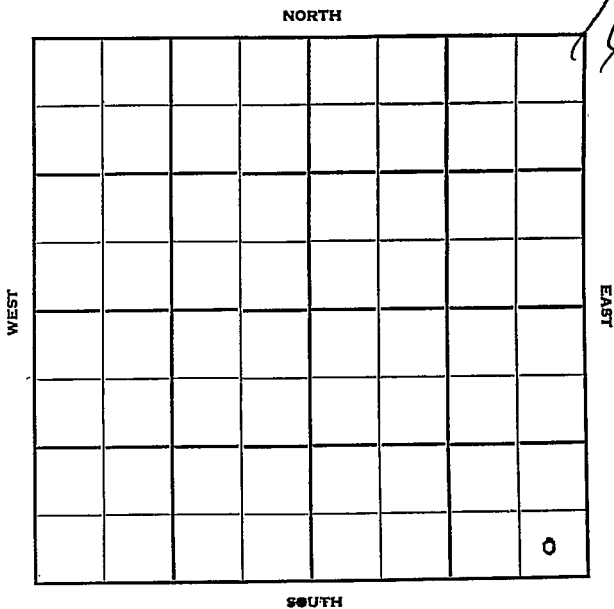

Barton

KANSAS
12 W ✓

Sec. 29 Twp. 19 R. 12 W

Well No. # 2 Schartz Farm _____

Alpine Oil & Derby et al Company _____

Quaker Drlg. Contractor _____


Fort Zarah Pool

_____ Ft. from N. Line

330 Ft. from S. Line

330 Ft. from E. Line

_____ Ft. from W. Line

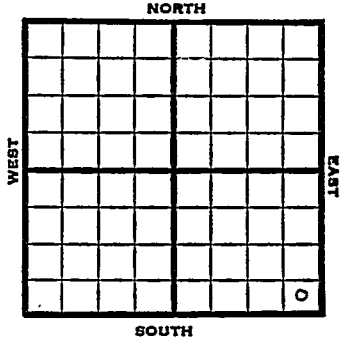

SE SE SE

1951 Elev. 1817' REPORT

7/25 Spud 7-17-51
8" @ 325'
Anhy 605'
Drlg. 2754'

9/12 Spud 7-17-51 Oil well TD 3372'
8" @ 325 Anhy 605' Heeb 2977'
Br. line 3096' Lans. 3110'
DST 3247-3340 open 1 hr. rec 240'
HOCSW 420' mud & OCSW, 180' GCM
Cong. 3353' Arb. 3366-70'
5" @ 3368' TD 3372' FU 650' oil
1000 A S/8 BOPH 1500 A
S/18 BOPH
Comp. 450 BOPD

COMPLETED

