


Section O.W.W.O. 29 Township 19 Range 12 W

Well No. # 2 Leoscha

Company ~~Lion Oil~~ Monsanto

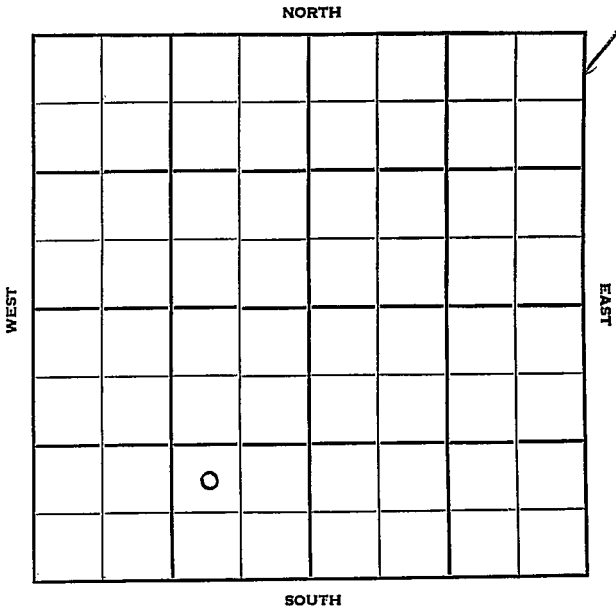

— — —

29 **O.W.W.O.** Barton **KANSAS**
 Sec. _____ Twp. 19 R. 12W ✓

Well No. #2 Leoscha Farm

~~Lion Oil~~ *Monsanto* Company

Rine Drlg. -Contr. Contractor


Fort Zarah Pool

_____ Ft. from N. Line

990' Ft. from S. Line

990' Ft. from E. Line

_____ Ft. from W. Line

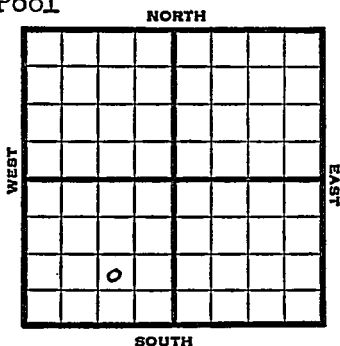

NW SE SW

1951

Elev. 1822' REPORT

5/29

RUR

7/25

Spud 5-30-51 Oil well TD 3365'
 9" @ 198 Lans. 3114'
 DST 3115-90 open 2 min. rec 100' GCM
 Heeb 2980' Arb. 3360' 5" @ 3362
 TD 3365 CO to 3331 24/3316-24
 23/3308-16 12/3304-08 1000 A
 S/3½ BF 1½ hr. SP 3295' 24/3280-
 88 24/3262-70 24/3245-53
 1000 A F/45 BO 15 min.
 F/34 BOPH
 Comp. 2418 BOPD

COMPLETED

1956
6/20

O.W.W.O.
 Old Info: OTD 3365; was Lsg prod
 Comp 8-51

New Info

L 3114

A 3360

DD 3373, swb 12 bo no wtr 1 hr;
 swb 10 BOPH no wtr 12 hrs; swb 8¼
 boph Grav 38 Ran tbg & rods
 POP pmp 51 BOPD

6-27

Complete

TD 3373'

COMPLETED

O.W.W.O.

FORM 513 SUNRAY

O.W.O.

County Barton Elev. _____
 Sec. 29 Twp. 19S Rge. 12W
 Company Monsanto
 Farm Name Leosha No. 2

TOPS	DEPTH	LOG	DATUM	Loc. in Sec.														
Anh.				App NW SE SW														
Tp.				1650' FWL														
H.				832 FSL														
Tr.																		
Dg.																		
Bl.																		
L.	3114			Geol. _____														
K.C.				Contr. _____														
B.K.C.																		
Ce.																		
C.																		
M.																		
M.				Pool														
K.				<u>Ft. Zarah</u>														
Mz.				<table border="1"> <tr> <td colspan="2">FIRST REPORT</td> </tr> <tr> <td></td> <td></td> </tr> <tr> <td></td> <td></td> </tr> <tr> <td></td> <td></td> </tr> <tr> <td></td> <td></td> </tr> <tr> <td></td> <td></td> </tr> <tr> <td></td> <td></td> </tr> </table>	FIRST REPORT													
FIRST REPORT																		
Me.																		
V.																		
S.																		
S.	3360																	
A.																		
R.																		
PE.																		
G.																		
T.D.																		

Date Comm. Old info - OTD 3365; was Lsg. prod completed 8-51

New info - DD 3373; swb 12 bo no wtr. 1 hr.; swb 10 boph no wtr. 12 hrs.; swb 8 1/4 boph

38^o Gr. ran tubing & rods; POP pmp 51 boph

Ø

~~01130~~ 13

County Barton Elev. _____
 Sec. 29 Twp. (19S) Rge. 12W
 Company Monsanto
 Farm Name Leosha No. 2

Co.

TOPS	DEPTH	LOG	DATUM	Loc in Sec.
Anb.				App NW SE SW
TP.				1650' FWL
H.				832 FSL
Tr.				
Dg.				
Bl.				
L.	3114			
K.C.				Geol. _____
B.K.C.				Contr _____
Ce.				
C.				
M.				
M.				Pool _____
K.				
Mz.				Ft. Zarrah
Mq.				
V.				
S.				COMPLETE
S.				
A.	3360			
R.				
PE.				JUN 27 '55
G.				0
TD.	3373			

Lse.

No.

Sec.

T.

R.

Date Comm. Old info - OTD 3365; was Lsg. prod completed 8-51

New info - DD 3373; swb 12 bq no wtr. 1 hr.; swb 10 boph no wtr. 12 hrs.; swb 8 1/4 boph

38⁰ Gr. ran tubing & rods; POP pmp 51 bopd

JUN 27 '55 complete

6