


Section 29 Township 19 Range 12W

Well No. 5 Leosha

Company Lion Oil

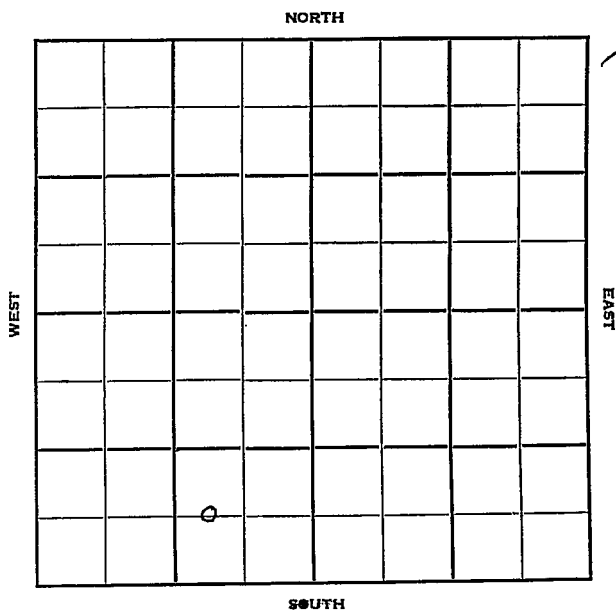

Barton

KANSAS

Sec. 29 Twp. 19 R. 12 W

Well No. # 5 Leosha Farm

Lion Oil Company

Rine Drlg. Contractor

Fort Zarah


\_\_\_\_\_ Ft. from N. Line

660 Ft. from S. Line

990 Ft. from E. Line

\_\_\_\_\_ Ft. from W. Line

C W L SE SW

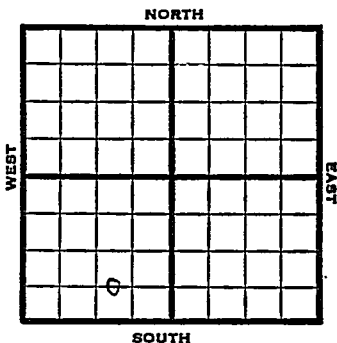

1951 Elev. 1821' REPORT

7/18 Spud 7-17-51  
Drlg. 450'

8/15 Spud 7-17-51  
Oil well TD 3394'  
Heeb 2979' Br. lime 3097' Lans 3111'  
DST 3118-90 open 3 min. rec 90' GCM  
Cong. 3355' Arb. 3392-94  
5" @ 3393 TD 3394 S/3 BOPH  
500 A S/50 BOPH  
Comp. BHB 3000 BOPD

COMPLETED

County Barton State Kansas

Sec. 29 (Blk. 19 (Sur. 12W (Twp. 19 (Rge. 12W Map No.

Operator Lion Oil

Well No. 5 Farm Leasha

Elev. \_\_\_\_\_ Location C W 1. SE SW

|  |  |  |  |  |  |
|--|--|--|--|--|--|
|  |  |  |  |  |  |
|  |  |  |  |  |  |
660 Ft. From S Line SW

990 Ft. From B Line Quarter

Ist. Report JUL 18 1951

Completion \_\_\_\_\_

Remarks \_\_\_\_\_

Rine Drlg. + Contr.

Spudding Date 7-17-51

Drlg. Data Foot Zarah Pool

drlg. 450

J. E. TYRA

