


Section 29 Township 19 Range 12W

Well No. #3 Leosha

Company Lion Oil

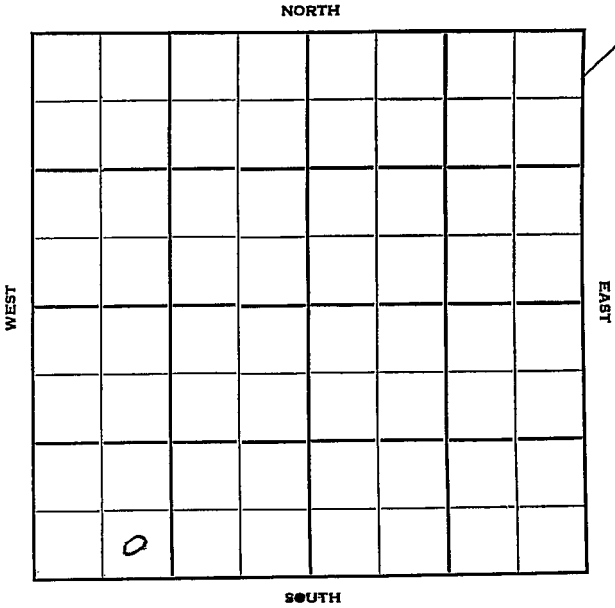

Barton

KANSAS

Sec. 29 Twp. 19 R. 12 W

Well No. # 3 Leosha Farm

Lion Oil Company

Fort Zarah Contractor


_____ Ft. from N. Line

330 Ft. from S. Line

_____ Ft. from E. Line

990 Ft. from W. Line

SE SW SW

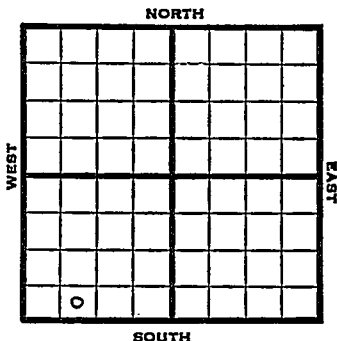

1951

Elev. 1822' REPORT

6/20

Location

8/1

Spud 6-2-451
 Oil Well TD 3404
 9" @ 147
 Heeb. 2980 Br Line 3098
 Lans. 3114
 DST 3117-90 opn 10 min. rec 240'
 gcm 600' sw
 Cong. 3358 Arb. 3402-04
 5" @ 3403 TD 3404
 B/15 goph 500 A S/3 boph
 Comp. 223 bopd

COMPLETED

