


Section 29 Township 19 Range 12W

Well No. 6 Leosha

Company Lion Oil

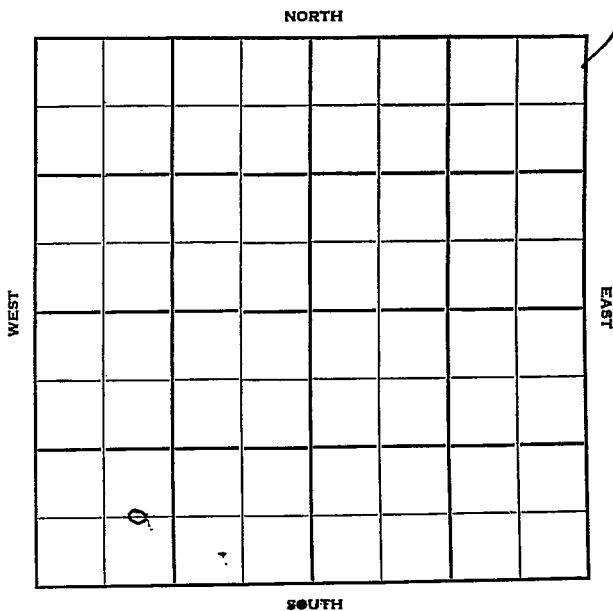

Barton

KANSAS

Sec. 29 Twp. 19 R. 12 W ✓

Well No. # 6 Leosha Farm

Lion Oil Company

Contractor

Fort Zarah Pool

Ft. from N. Line

660


Ft. from S. Line

Ft. from E. Line

990

Ft. from W. Line

C E L SW SW

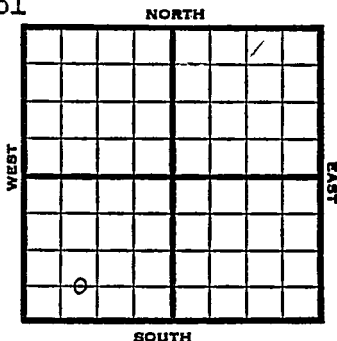

1951

Elev. 1822'

REPORT

7/25

Location

8/22

Spud 7-26-51

Oil well TD 3380' 8" @ 128

Heeb 2982' Br. lime 3098'

Lans. 3112' Cong. 3369' Arb. 3377-

80' 5" @ 3378' 15/3324-29

21/3308-15 12/3282-86 18/3263-69

24/3246-54 1000 A F/50 BOPH

Comp. BHB 1736 BOPD

COMPLETED



