


Section 29 Township 19 Range 12W

Well No. 7 Leosha

Company Lion Oil

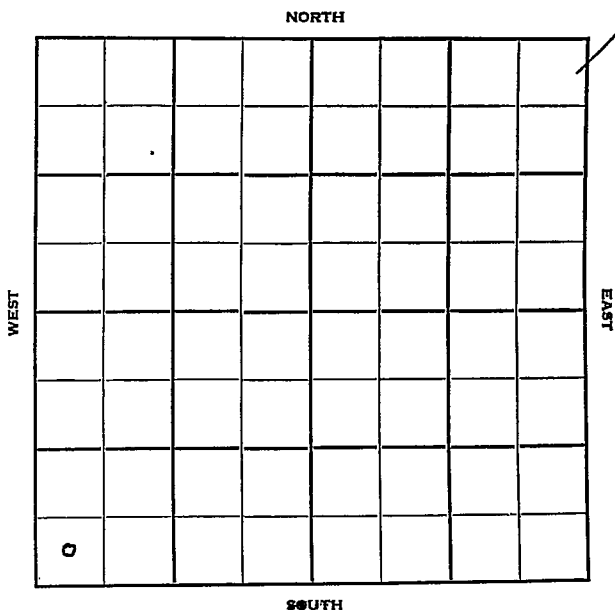

Sec. 29 Twp. 19 R. 12W

Well No. #7 Leosha Farm

Lion Oil Company

Contractor

Fort Zarah Pool


Ft. from N. Line

330' Ft. from S. Line

Ft. from E. Line

330' Ft. from W. Line

SW SW SW

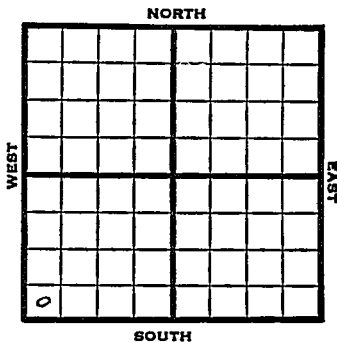

1951

Elev. 1822' REPORT

7/25

Location

10/3

Spud 8-4-51
Oil well TD 3390' 8" @ 118'
Heeb. 2983' Br. lime 3100' KC 3115'
DST 3119-90 open 4 min. gas in 3 min.
rec 120' GCM.
Cong. 3359' Arb. 3374-78'
5 1/2" @ 3375 TD 3380' S/1 1/2 BOPH
DD 3390' S/5 1/2 BOPH
Comp. 169 BOPD

COMPLETED

County Barton State Kansas

Sec. 29 (Blk. Twp.) 19 (Sur. Rge.) 12W Map No.

Operator Lion Oil

Well No. 7 Farm Leosha

Elev. Location SW SW SW

FIRST REPORT											
0											

330 Ft. From S Line SW

330 Ft. From W Line Quarter

JUL 25 1951

Ist. Report

Completion

Remarks

Spudding Date

Drlg. Data Fort Zarah Pool

Location

J. E. TYRA

