


Section 3 Township 19 Range 11 W

Well No. # 2 Klepper (B)

Company Mastin & Hyde

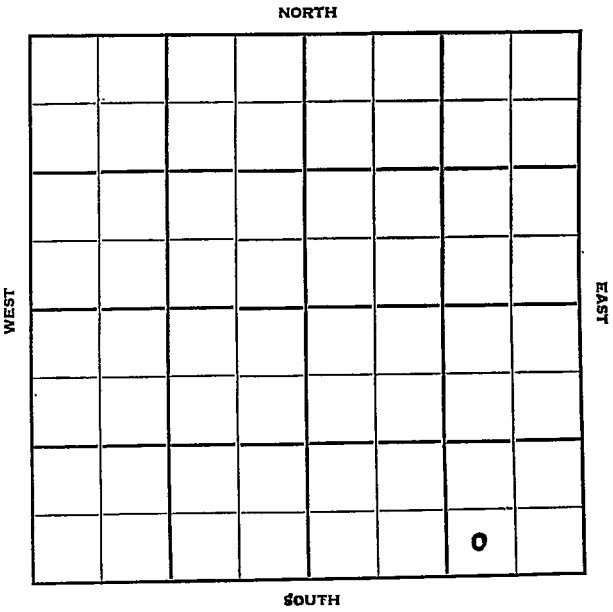

Sec. 3 Twp. 19 R. 11W

Well No. #2 Klepper (B) Farm

Mastin & Hyde Company

Isern Contractor

Klepper


Ft. from N. Line

330 Ft. from S. Line

990 Ft. from E. Line

Ft. from W. Line

SW SE SE

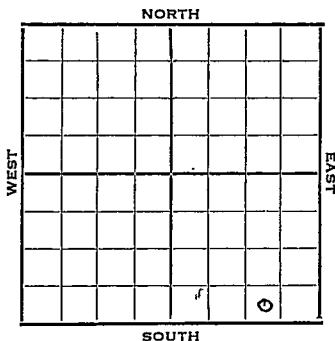

1952

Elev. 1773' REPORT

5/28

Spud 5-22-52
10" @ 180'
Anhy 564'
Drlg. 2532'

6/11

Topeka 2646' Heeb 2913' Lans. 3048
DST 3133-45, 3/4 hr. 55' muddy SW
RTD 3225' 5" @ 3216 DP 3225
500 A S/5 BO 1 hr. POP

6/18
6/25

NR
Spud 5-22-52
Oil Well TD 3225
10" @ 180' Anhy 564
Top 2646' Heeb. 2913
Lans. 3048
DST 3133-45 opn 3/4 hr. Rec. 55'
muddy SW TD 3225
5" @ 3216 DP 3225 500 A
S/5 boph Comp. 112 bopd

COMPLETED

