

Section 3 Township 19 Range 11WWell No. #1 ~~#2~~ Klepper (C)Company C. E. ASH & L. B. Smith

NORTH

|  |  |  |  |  |   |  |  |
|--|--|--|--|--|---|--|--|
|  |  |  |  |  |   |  |  |
|  |  |  |  |  |   |  |  |
|  |  |  |  |  | 0 |  |  |

SOUTH

WEST

EAST

Sec. 3 Twp. 19 R. 11WWell No. #1  
#2 Klepper (C) Farm

C.E. Ash &amp; L. B. Smith Company

C. E. Ash Contractor  
Plepper


Ft. from N. Line

330 Ft. from S. Line

Ft. from E. Line

990 Ft. from W. Line

SE SW SE

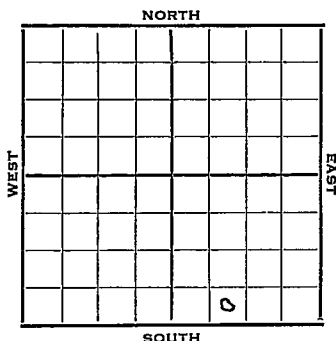

1952 Elev. 1779' REPORT

9/10 RU

9/17 7" @ 201'  
Drlg. 2130'9/24 Topeka 2654 Heeb. 2921  
Br Li 3040 Lans. 3059  
DST 3193-3207 3/4 hr. 9 1/2 M  
DST 3227-35 1/2 Hr. 200' M & O  
10' SW 460# Cong 3352  
RTD 3366 Schl 5" @ 3279

10/1 NR

10/8 "

10/15 "

10/22 NR

10/29 CO 20/3220-33, 1000<sup>A</sup>, S/4 BOPH 20 hrs.

11/5 NR

11/12 P/209 BO plus 71 BW 12 hrs.

11/19 Spud 9-11-52

Oil well TD 3366' 7" @ 201  
Top. 2654' Heeb 2921' Br. lime  
3040' Lans. 3059'DST 3193-3207 open 3/4 hr. rec 9 1/2' mud  
DST 3227-35 open 1/2 hr. rec 200' mud &  
oil, 10' SW 460# Cong. 3352'  
TD 3366' 5" @ 3279 20/3220-33  
1000 A S/4 BOPH P/209 BO 71 BW 12hr  
Comp. 95 BOPD 8% wtr.

County Barton State Kansas

Sec. **3** (Blk. **19** (Sur. **11W** Map No.

Operator C. E. Ash & L. B. Smith

Well No. **2** Farm **Klepper (C)**

| Elev. | Location | SE | SW | SE |
|-------|----------|----|----|----|
|-------|----------|----|----|----|

**FIRST REPORT**

330 Ft. From S Line SE

| 990 | Ft. From | W Line | Quarter |
|-----|----------|--------|---------|
|-----|----------|--------|---------|

1st. Report. SEP 10 1952

### Completion

Remarks.

C. E. Ash - Contr.

Spudding Date

Drlg. Data Klepper

RU

J. G. McGEHEE

Kansas

Map No. \_\_\_\_\_ Sec. 3 Twp. 19 R. 11WWell No. 1 Klepper "C"C.E. Ash & L.B. Smith Company

CORRECTION

Contractor

SE SW SE

## SECTION PLAT

|  |  |  |   |
|--|--|--|---|
|  |  |  |   |
|  |  |  |   |
|  |  |  |   |
|  |  |  |   |
|  |  |  | o |

\_\_\_\_\_ Ft. from N. Line

330 Ft. from S. Line

\_\_\_\_\_ Ft. from E. Line

990 Ft. from W. Line

Barton County

Location \_\_\_\_\_

Rig up \_\_\_\_\_

Drilling and Remarks:

Reported

#2 Klepper "C"

## RECORD

Cased \_\_\_\_\_ in., \_\_\_\_\_ ft.

Sand \_\_\_\_\_

Gas \_\_\_\_\_

Oil \_\_\_\_\_

Total Depth \_\_\_\_\_

## PRODUCTION

1st 24 hrs. Nat. \_\_\_\_\_

1st 24 hrs. after shot \_\_\_\_\_

Gas \_\_\_\_\_ Cu. Ft.

Dry Hole \_\_\_\_\_

Abandoned \_\_\_\_\_

Date

19


Scout

County Barton State Kansas  
 Sec. 3 (Blk. 19) (Sur. 11W) Map No.

Operator C.E. Ash & L.B. Smith

Well No. 1 Farm Klepper "C"

Elev. 1779 Location SE SW SE

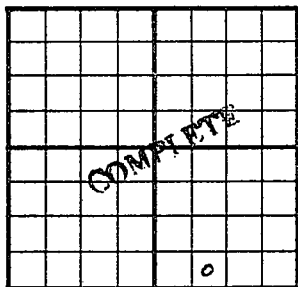

330 Ft. From S Line SE

990 Ft. From W Line Quarter

1st. Report

Completion NOV 19 1952

Remarks Klepper Pool  
Ash - Contr.

Spudding Date 9-11-52

Drlg. Data Oil well TD 3366

7" @ 201 Top. 2654 Heeb. 2921

Br. lime 3040 Lans. 3059 DST 3193-3207

open 3/4 hr. Rec. 9 1/2' mud DST 3227-35

open 1/2 hr. Rec. 200' mud & oil 10' sw

460# Cong. 3352 TD 3366 5" @ 3279

20/ 3220-33 1000 A S/ 4 boph

P/ 209 bo 71 bw 12 hr.

Comp. 95 bopd 8% wtr.

J. G. McGEHEE