

Barton

KANSAS

3

19


11W

SECTION _____ TOWNSHIP _____ RANGE _____

WELL NO. ²
#1 Birzer

COMPANY Nadel-Gussman

NORTH NW NE NW

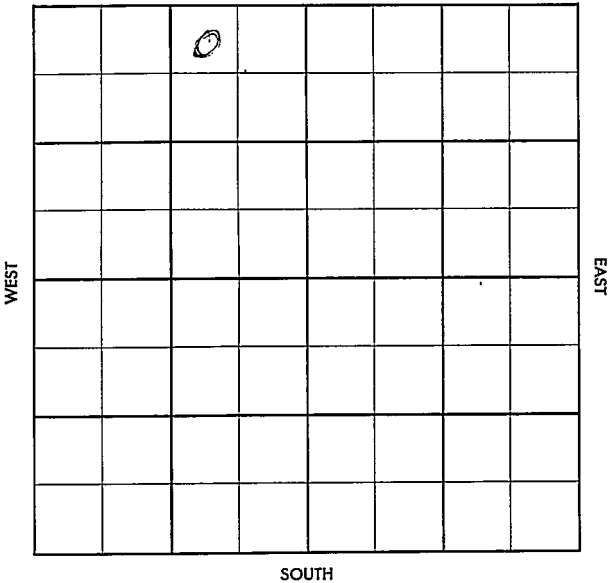

County Barton

Elev. _____

Sec. 3Twp. 19Rge. 11WCompany Nadel-GussmanFarmName BirzerNo. 7

TOPS

DEPTH

LOG

DATUM

Loc. in Sec. _____

Anh. _____

Tp. _____

H. _____

Tr. _____

Dg. _____

Bl. _____

L. _____

K.C. _____

B.K.C. _____

Ce. _____

C. _____

M. _____

M. _____

K. _____

Mz. _____

Mq. _____

V. _____

S. _____

S. _____

A. _____

R. _____

PE. _____

G. _____

T.D. _____

NW NE NW

Geol. _____

Contr. _____

Reserve Tools

Pool

St. Peter

FIRST REPORT

MAR 6 '57

Date Comm. _____

M I R T

13

CORRECTION

County Barton Elev. 1795
 Sec. 3 Twp. 19 Rge. 11W
 Company Nadel-Gussman
 Farm Name Birzer No. 2

TOPS	DEPTH	LOG	DATUM	Loc. in Sec.
Anh.				NW NE NW
Tp.	2656			
H.				
Tr.				
Dg.				
BL.	3036			
L.	3052			Geol.
K.C.				Contr.
B.K.C.				Reserve Tool
Ce.				Pool
C.	3347			St. Peter
M. C95d	3354			
M.				
K.				
Mz.				
Ma.				
V.				
S.				
S.				
A.	3379			
R.				
Pe.				
G.				
T.D.	3403			

	MAY 1 '57	

COMPLETE

Date Comm.

M I R T MAY 13 57 3-6-57 8 3/4 104
 DST 2858-70 (75) 925 (4) res 2750'
 D₁ 1, FP 120-810 - BHP 1040, DST
 3231-40 MAR 10 57 or 1 hr res 55'
 Ho 5' GCM BHP 880 C9 3347 C9 32d
 3354 A16 3379 RTP 3403 D₁ 109
 5 1/2 @ 3401 WOCT
 Rig to # 5 de hanning MAR 22 57 MICI
 APR 3 57 CO 25/3201-05 no + ST

A Flwd 60 Boph 2 hrs

T & R APR 10 57 APR 17 57 APR 24 57 MAY 1 57

X St. Pot. P. 400 BOPD
nowth 7 grow

Lsg PF 3201-05

RTD 3403