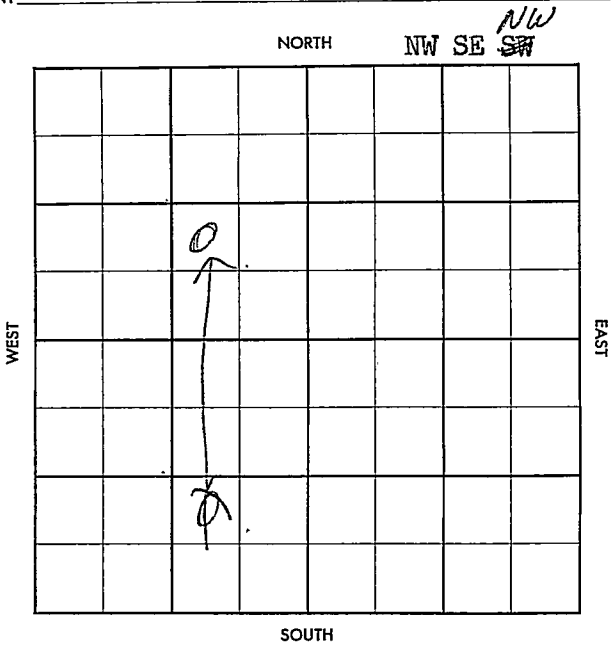


Barton

KANSAS

SECTION 3 TOWNSHIP 19S RANGE 11WWELL NO. #6 BirzerCOMPANY Nadel & Gussman

Elev.

Sec.

Two.

198

Res.

11W

Company Nadel & Gussman

FarmName Birzer

No. 6

TOPS	DEPTH	LOG	DATUM
Anh.			
T.P.			
H.			
Tr.			
Dg.			
BL.			
L.			
K.C.			
B.K.C.			
Ce.			
C.			
M.			
M.			
K.			
Mz.			
Mq.			
V.			
S.			
S.			
A			
R.			
PE.			
G.			
T.D.			

Loc. in Sec.

NE SE SW

Geol.

Contr

Reserve Tools

Pool

Klepper

FIRST REPORT

30

156

No.

365

1.

1

13

CORRECTION

FORM 513 SUNRAY

County BartonElev. 17961BSec. 3 Twp. 19SRgs. 11WCompany Nadel & GussmanFarmName BirzerNo. 6

TOPS	DEPTH	LOG	DATUM
Anh.	<u>590</u>		
Tr.			
H.			
Tr.			
Dg.			
Bl.	<u>3038</u>		
L.	<u>3065</u>		
K.C.			
B.K.C.			
Ce.			
C.			
M.			
M.			
K.			
Mz.			
Mo.			
V.			
S.			
S.			
A.	<u>3385</u>		
R.			
PE.			
G.			
T.D.	<u>3892</u>		

Loc. in Sec.

NW SE NW

Geol.

Contr.

Reserve Tools

Pool

Klepper

OCT 23 '57

COMPLETE

Date Comm.

RURT SEP 18 '57 9-10 -57 8⁵/₈ 307/140

DST 2868-79 30" 5' Md RHP 870

DST 3070-3100 1 1/2 hrs 150' GSSy

Md imp DST 3102-20 1 1/2 hrs

90' 50 cm RHP 290/30"

SEP 20 3850 OCT 5" 3690

11/19 OCT 9 '57 19/3111-13 19/3117-20

19/3122-25 18/3130-33 25/3150-54

11 3150-54 ~~SEED~~

1) all zones \$4 Boph nw

80.10 '57

OCT 23 '57

P/LY 127 BO + 209nw
gr 42°

3-19-11W

nw se nw