


Section 3 Township 19 Range 11WWell No. #1 Kleeper (B) (Klepper)Company Ben Hyde et al

NORTH

WEST

EAST

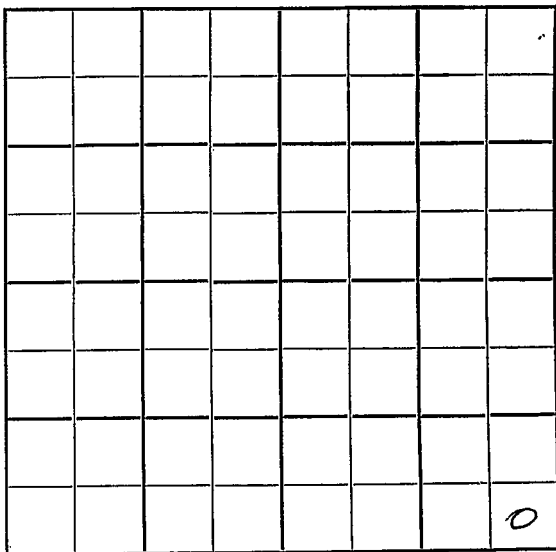

SOUTH

Barton

KANSAS

Sec. 3 Twp. 19 R. 11W

Well No. #1-Klepper (B) Farm

Ben Hyde et al Company

Todd Contractor

Klepper


 Ft. from N. Line

330 Ft. from S. Line

330 Ft. from E. Line

 Ft. from W. Line

SE SE SE

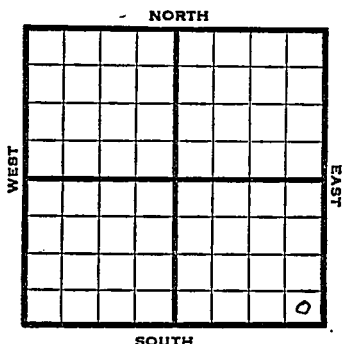

1951

Elev. 1778'

REPORT


10/31

RUR

12/12

Spud 11-1-51
Oil Well TD 3369
8" @ 165
Heeb. 2918
Brlime 3036
Lans. 3054
DST 3057-87 opn $\frac{1}{2}$ hr
Rec. 40' gcm DWT 3136-47 opn $\frac{1}{2}$ hr
Rec. 240' gas 122' so & gcm
Cong 3353 5" @ 3278
TD 3369 CO to 3265
12/3221-25 1000 A Comp. 165 bopd

COMPLETED

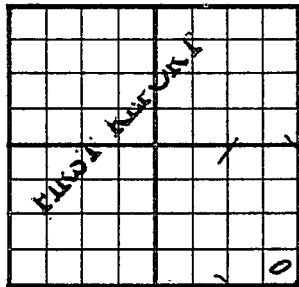County Barton State KansasSec. 3 (Blk.) 19 (Sur.) 11W Map No.Operator Ben Hyde etal.Well No. 1 Farm Klepper (B)Elev. Location SE SE SE330 Ft. From S Line SE330 Ft. From E Line QuarterIst. Report OCT 31 1951

Completion


Remarks

Todd - Contr.

Spudding Date

Drlg. Data KlepperRORJ. E. TYRA

County Barton State Kansas
 Sec. 3 (Blk.) 19 (Sur.) 11W Map No.
 Operator Ben Hyde et al.
 Well No. 1 Farm Klepper "B"
 Elev. 1778 Location SE SE SE

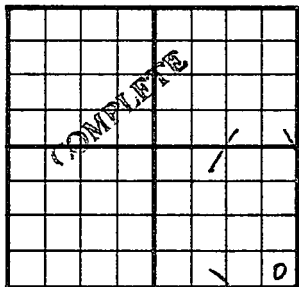

330 Ft. From S Line SE
330 Ft. From E Line Quarter
 Ist. Report
 Completion DEC 1 2 1951
 Remarks Klepper Pool
Todd Drlg. - Contr.
 Spudding Date 11-1-51

Drlg. Data Oil well TD 3369

8" @ 165 Heeb. 2918 Br. lime 3036

Lans. 3054 DST 3057-87 open $\frac{1}{2}$ hr.

Rec. 40' gcm DST 3136-47 open $\frac{1}{2}$ hr.

Rec. 240' gas 122' so & gcm Cong. 3353

5" @ 3278 TD 3369 CO to 3265

12/ 3221-25 1000 A Comp. 165 bopd