


Section 3 Township 19 Range 10W

Well No. #3 Boldt

Company Gabbert & Jones & Weaver

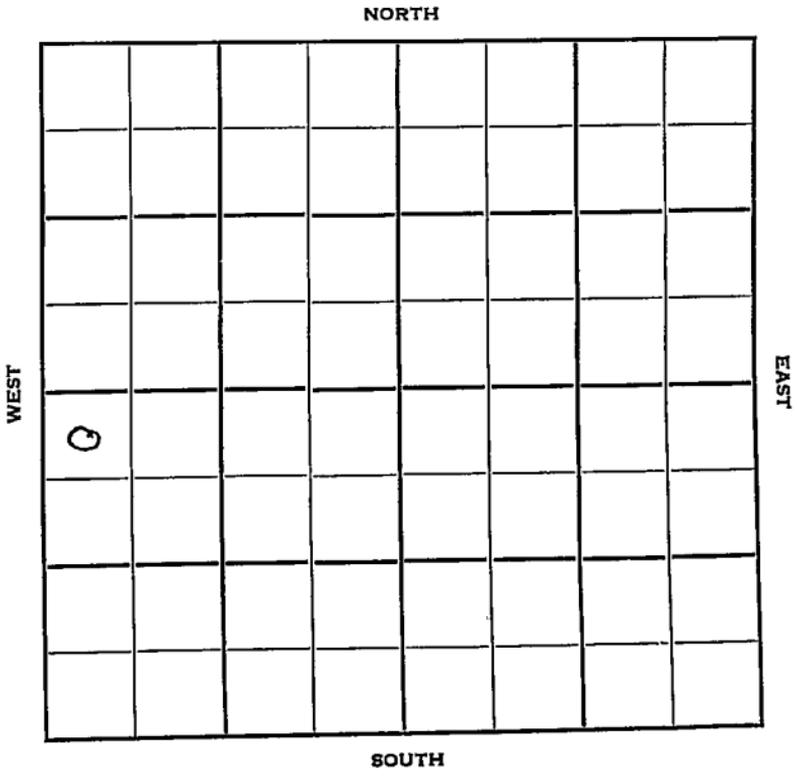

Rice

KANSAS ✓

Sec. 3 Twp. 19 R. 10N

Well No. #3 BoIdt Farm

Gabbert & Jones & Weaver Company

" Contractor


330 Ft. from N. Line

_____ Ft. from S. Line

_____ Ft. from E. Line

330 Ft. from W. Line

NW NW SW

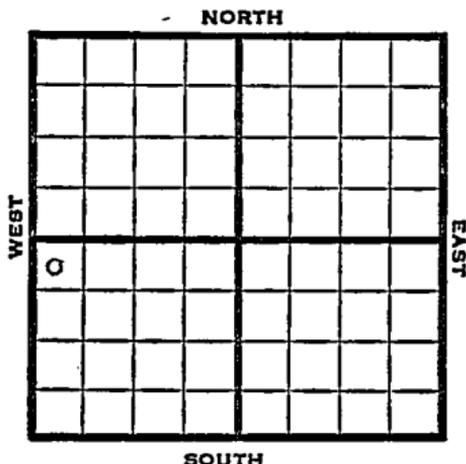

1952 Elev. 1736' REPORT

9/10 Location
 9/17 8" @ 193'
 9/24 Lans. 2965
 Drlg. 3027
 10/1 Spud 9-13-52
 D&A TD 3346 8" @ 193
 Lans. 2965 Heeb. 2815
 Br Li 2940 KC 2970
 DST 3053-60 open 1 hr. rec. 22'
 SGCM 940# Cong. 3280
 DST 3256-3318 open 1/2 hr. rec. 10' mud
 440# Arb. 3318' TD 3346 D&A

ABANDONED

County Rice State Kansas

Sec. 3 (Blk. Twp.) 19 (Sur. Rge.) 10W Map No.

Operator Gabbert & Jones & Weaver

Well No. 3 Farm Boldt

Elev. 1736 Location NW NW SW

0					
ABANDONED					

330 Ft. From N Line SW

330 Ft. From W Line Quarter

1st. Report

Completion OCT 1 1952

Remarks

Gabbert & Jones - Contr.

Spudding Date 9-13-52

Drlg. Data D & A TD 3346

8" @ 193 Lans. 2965 Heeb. 2815

Br. lime 2940 KC 2970 DST 3053-60

open 1 hr. Rec. 22' sgcm 940#

Cong. 3280 DST 3256-3318 open 1/2 hr.

Rec. 10' mud 440# Arb. 3318 TD 3346

D & A

u.