


Section 3 Township 19 Range 10 W

Well No. # 1 Mehl

Company Carl Lebsock

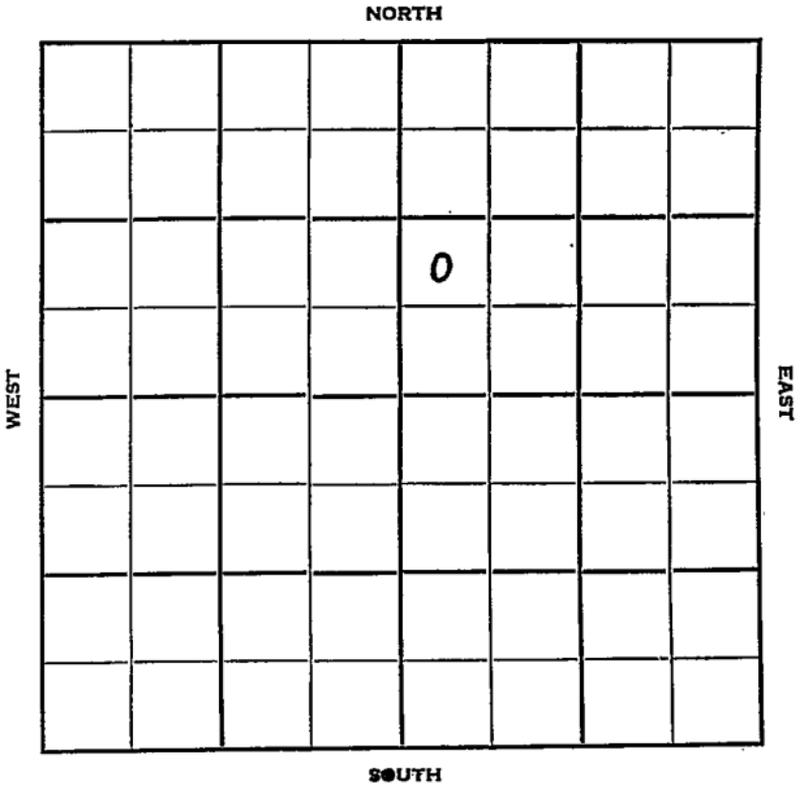

Sec. 3 Twp. 19 R. 10W

Well No. #1 Mehl Farm

Carl Lebsock Company

Isern Bros. Contractor


_____ Ft. from N. Line

990 Ft. from S. Line

_____ Ft. from E. Line

330 Ft. from W. Line

NW SW NE

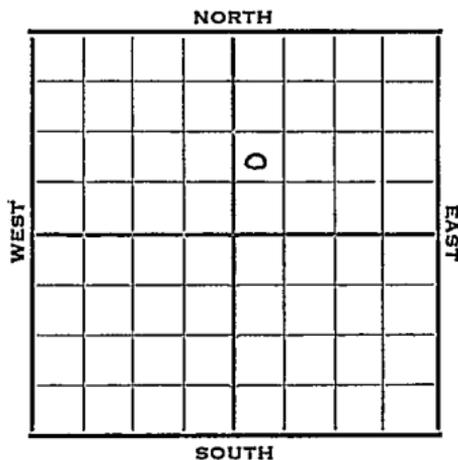

1952 Elev. 1733' REPORT

6/25 Spud 6-20-52
8" @ 150'
Anhy 440'
Drlg. 2020'

7/2 Spud 6-20-52
D&A TD 3340 8" @ 150'
Anhy 440 Heeb. 2799
Br Li 2922 Lans. 2939
Cong. 3264 Ch Cong. 3281
TD 3340 D&A

ABANDONED


County Rice State Kansas

Sec. 5 (Blk. Twp.) 19 (Sur. Rge.) 10W Map No.

Operator Carl Lebsack

Well No. 1 Farm Mehl

Elev. Location NW SW NE

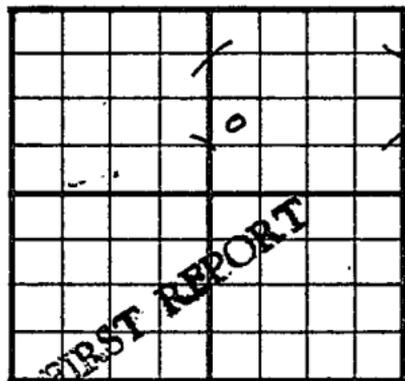

990 Ft. From S Line NE

330 Ft. From W Line Quarter

Ist. Report JUN 25 1952

Completion _____

Remarks _____

Isern Bros. • Conty.

Spudding Date 6-20-52

Drig. Data _____

8" @ 150 Anhy 440 Drig. 2020

J. G. McGEHEE


County Rice State Kansas

Sec. 3 (Blk. Twp.) 19 (Sur. Rge.) 10W Map No.

Operator Carl Lebsack

Well No. 1 Farm Mehl

Elev. 1733 Location NW SW NE

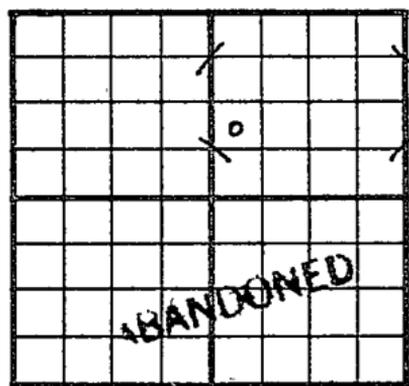

990 Ft. From S Line NE

330 Ft. From W Line Quarter

Ist. Report

Completion JUL 2 1952

Remarks

Isern Bros. - Contr.

Spudding Date 6-20-52

Drlg. Data D & A TD 3340

8" @ 150 Anhy 440 Heeb. 2799

Br. lime 2922 Lans. 2939 Cong. 3264

Ch. Cong. 3281 TD 3340

D & A