
FORM 51 25M 8-50 WESTERN Rice KANSAS

Section 3 Township 19 Range 10 W

Well No. # 2 Ringwald

Company Weaver & Gabbert

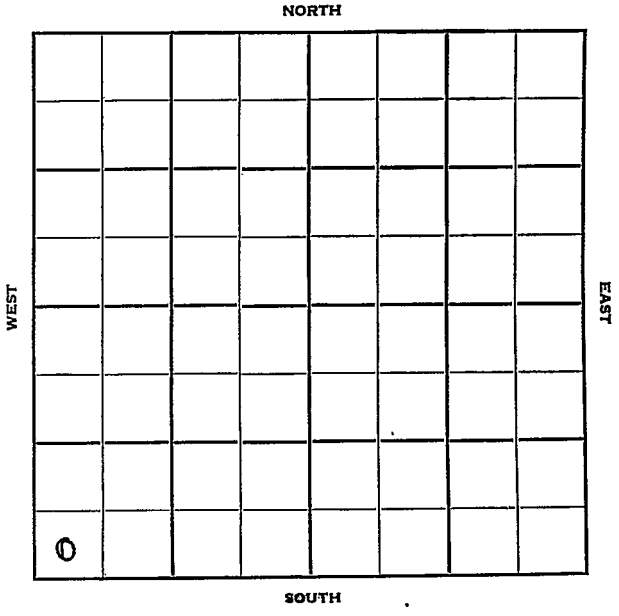

FORM 252-B
10M 11-50 PETROL

Rice KANSAS

Sec. 3 Twp. I9 R. 10 W

Well No. ~~#1~~ #2 Ringwald ✓ Farm

Weaver & Gabbert Company

Gabbert Contractor


____ Ft. from N. Line

330 Ft. from S. Line

____ Ft. from E. Line

330 Ft. from W. Line

SW SW SW

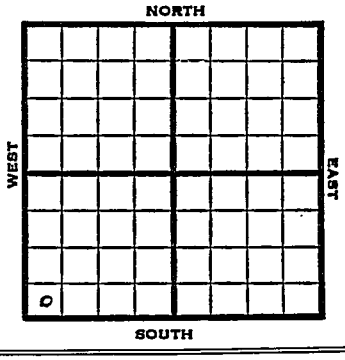

1951	Elev. 1749' REPORT
12/12	Cellar & Pits
1952 1/2	Spud 12-14-51 D & A TD 3332' 8" @ 186' Lans. 2978' DST 3043-56 open 1 hr. rec 15' mud DST 3059-70 open 1 hr. rec 45' mud Cong. 3308' Arb. 3326' DST 3328-32' open 1 hr. rec 35' mud D & A ABANDONED

FORM 275 FOR SALE BY KANSAS BLUE PRINT CO.


County Rice State Kansas

Sec. 3 (Blk. Twp.) 19 (Sur. Rge.) 10W Map No.

Operator Weaver & Gabbert

Well No. 1 Farm Ringwald

Elev. Location SW SW SW

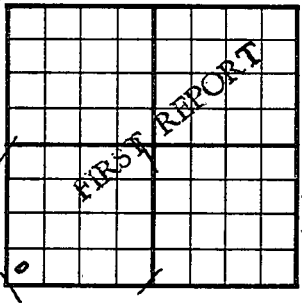

330 Ft. From S Line SW

330 Ft. From W Line Quarter

1st. Report DEC 1 2 1951

Completion

Remarks

Gabbert - Contr.

Spudding Date

Drlg. Data

Cellar & pits

See Correction Attached

J. E. TYRA

Form 26 200 Bks. 8-50 Petrol

Kansas

Map No. _____ Sec. 3 Twp. 19 R. 10W


Well No. 2 Ringwald

Weaver & Gabbert Company

CORRECTION Contractor

SW SW SW

SECTION PLAT

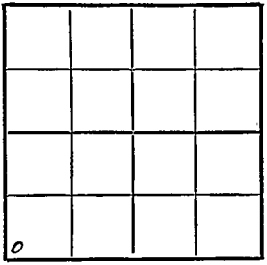

_____ Ft. from N. Line

330 Ft. from S. Line

_____ Ft. from E. Line

330 Ft. from W. Line

Rice County

Location _____

Rig up _____

Drilling and Remarks:

Reported
#1 Ringwald

RECORD

Cased _____ in., _____ ft.

Sand _____

Gas _____

Oil _____

Total Depth _____

PRODUCTION

1st 24 hrs. Nat. _____

1st 24 hrs. after shot _____

Gas _____ Cu. Ft.

Dry Hole _____

Abandoned _____

Date

DEC 1 2 1951 19

J. E. TYRA Scout

FORM 275 FOR SALE BY KANSAS BLUE PRINT CO.


County Rice State Kansas

Sec. 3 (Blk. Twp.) 19 (Sur. Rge.) 10W Map No.

Operator Weaver & Gabbert

Well No. 2 Farm Ringwald

Elev. 1749 Location SW SW SW

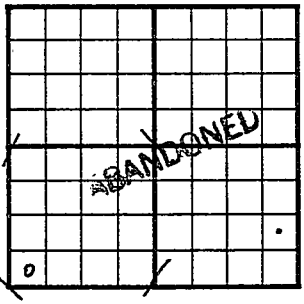

330 Ft. From S Line SW

330 Ft. From W Line Quarter

1st. Report

Completion JAN 2 1952

Remarks

Gabbert - Contr.

Spudding Date 12-14-51

Drlg. Data D & A TD 3332

8" @ 186 Lans. 2978 DST 3043-56

open 1 hr. Rec. 15' mud DST 3059-70

open 1 hr. Rec. 45' mud Cong. 3308

Arb. 3326 DST 3328-32 open 1 hr.

Rec. 35' mud

D & A

J. E. TYRA