


Section 3 Township 19 Range 10 W

Well No. #3 Schmidt

Company Lebsack

NORTH

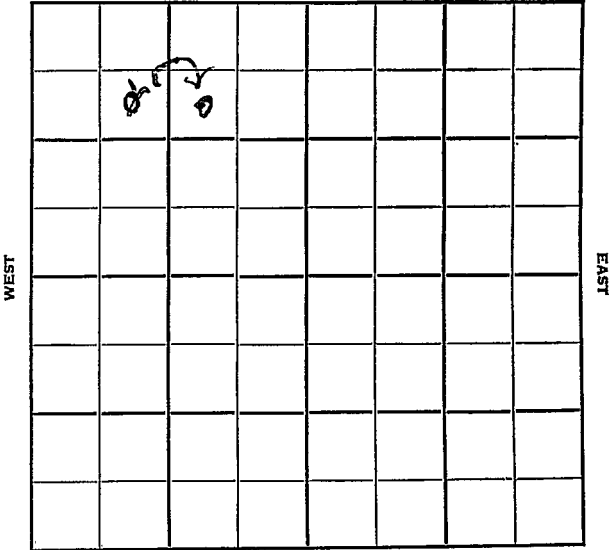

SOUTH

WEST

EAST

Sec. 3 Twp. 19 R. 10W -7

Well No. #3 - Schmidt Farm

Lebsack Company


Isern Contractor

990 Ft. from N. Line

_____ Ft. from S. Line

990 Ft. from E. Line

990 Ft. from W. Line

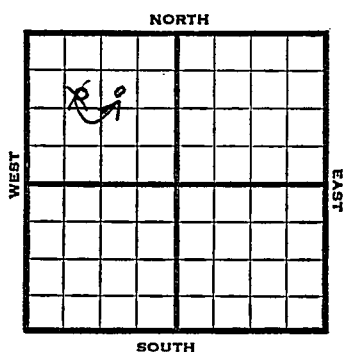

~~SE NW NW~~
SW NE NW

1952 Elev. 1731' REPORT

3/12 Drlg. 1300'

3/19 Heeb. 2792 Br Li 2915
Lans. 2934
DST 3010-20 1 hr. 200' oil 105'
MCO 770# Cong. 3251 Arb. 3274
RTD 3280 5" @ 3276

3/25 DD to 3289 S/ 2 1/2 BOPH for 2 hrs.
A to A would not take
DD to 3291 TD fill up 400' oil
2 hrs. S/ 3 BO 1 hr.

4/1 NR

4/9 "

4/16 Oil Well TD 3291
Heeb. 2792 Br Li 2915
Lans. 2934
DST 3010-20 open 1 hr. rec. 200' oil
105' mco Cong. 3251 Arb. 3274
TD 3280 5" @ 3276 DD 3289
S/ 2 1/2 boph 2 hr. DD 3291 FU 400' oil
2 hr. S/ 3 bo 1 hr.
Comp. 79 bopd

COMPLETED

Kansas

Map No. _____ Sec. 3 Twp. 19 R. 10W

Well No. 3 Schmidt

Lebsack

Company

CORRECTION

Contractor

SW NE NW

SECTION PLAT

990 Ft. from N. Line

_____ Ft. from S. Line

990 Ft. from E. Line

_____ Ft. from W. Line

	0		

Rice County

Location _____

Rig up _____

Drilling and Remarks:

Reported

SE NW NW

RECORD

Cased _____ in., _____ ft.

Sand _____

Gas _____

Oil _____

Total Depth _____

PRODUCTION

1st 24 hrs. Nat. _____

1st 24 hrs. after shot _____

Gas _____ Cu. Ft.

Dry Hole _____

Abandoned _____

Date

MAR 1 9 1952 19

J. G. MCGEHEE

Scout

