


Section 3- Township 19 Range 10W

Well No. #4 Schmidt

Company Carl Lebsack

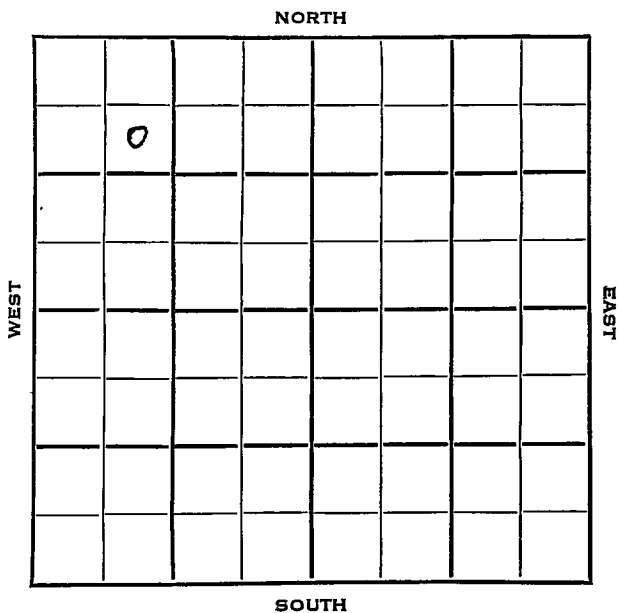

Rice

KANSAS

Sec. 3 Twp. 19 R. 10 W

Well No. # 1 Schmidt Farm

Carl Lebsack Company

Isern Drlg. Contractor

S. Munyon Pool


990 Ft. from N. Line

\_\_\_\_\_ Ft. from S. Line

\_\_\_\_\_ Ft. from E. Line

990 Ft. from W. Line

SE NW NW

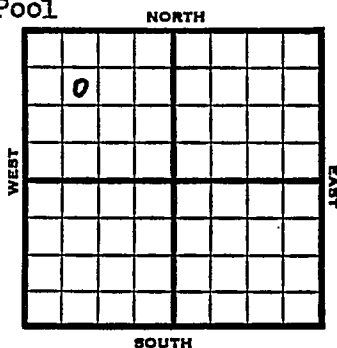

1953

Elev. 1738'

REPORT

9/2

MTR

9/9

8" @ 162'  
Drlg 2990'

9/16

RTD 3321  
5" @ 3315, CO 3321

9/23

Heeb 2799' Br li 3260 Arb. 3282  
CO 3321' S/5 1/2 BOPH 12 hrs. POP

9/30

N.R.

10/7

"

10/14

"

10/21

Spud 9-3-53 Oil well TD 3318'  
8" @ 162 Heeb 2799 Br line 2922  
Lans 2943 S/5 1/2 BOPH 12 hr.  
DST 3021-38 open 1 hr rec 30' mud 550#  
Cong. 3259 Arb. 3309'  
DST 3312-18 open 1 hr rec 700' oil  
740# 5" @ 3315 CO to 3318  
S/5 1/2 BOPH Comp. 24 BOPD

**COMPLETED**



