

Rice

FORM 252A-5M-8-30-PETROL

Map No. KANSAS Sec. 3 Twp. 19 R. 10^w

Well No. 1- ~~Palmer~~ Zink Farm

~~Solar Oil Co~~ Company

Solar Oil NORTH


 Ft. from N. Line

330 Ft. from S. Line

330 Ft. from E. Line

 Ft. from W. Line

1931

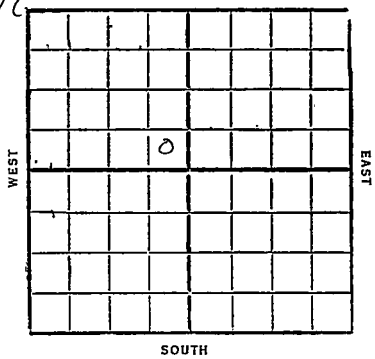

Date

4/22

4/29

5/6

5/13

5/20

5/27

6/3

6/10

6/17

6/24

7/1

7/6

7/8

REPORT

Loc

—

Pos.

Ran up

Rigd up + SID

15" - 450

drlg 560'

" 1390'

" 1820'

HFW 2495 - 2515

UIR 8" - 2560'

8" - 2550

drlg 3100'

Top Conglomerate 3231

small sho oil 3280-82

Ang 5" Csg

5" - 3281 Top Cong. 3265'

small showail (3281-83)

Top. Sil. line 3335'

HFW 3353'

SID 3358'

7/15 - Top Silic lime 3332
HFW 3354-58
T.D. 3358
Dry & Abandon

Rice

46 KANSAS Map No. Sec. 3 Twp. 19 R. 10^w

Well No. 1 3 MW
Solor Oil Co Company

Contractor

COMPLETE

SECTION PLAT

.....Ft. from N. Line

330 Ft. from S. Line

336 Ft. from E. Line

.....Ft. from W. Line

	0		

~~ABANDONED~~

Location

Rig up

Drilling and Remarks:

Top Oil 333
NW 335 4-58

RECORD

Cased.....in.,ft.

Sand.....

Gas.....

Oil.....

Total Depth 3358

PRODUCTION

1st 24 hrs. Nat.....

1st 24 hrs. after shot.....

Gas..... Cu. Ft.

Dry Hole

Abandoned

Date JUL 15 1931

192 HAS. L. SHERWOOD Scout

Done well

Returned	<i>J.P.</i>
Cards	<i>J.P.</i>
Tracing	<i>CPK</i>
France Map	<i>X</i>
Scarborough Map	<i>X</i>
Moody Map	<i>X</i>
Scarborough Plat Book	
Moody Plat Book	

Rice

46 KANSAS Map No. Sec. 3 Twp. 19 R. 10^W

Well No. 1 Reels

Delar Oil Co Company

Contractor

FIRST REPORTS

SECTION PLAT

.....Ft. from N. Line

330 Ft. from S. Line

330 Ft. from E. Line

.....Ft. from W. Line

	o		

Location..... ✓

Rig up.....

Drilling and Remarks:

RECORD

Cased..... in.,ft.

Sand.....

Gas.....

Oil.....

Total Depth.....

PRODUCTION

1st 24 hrs. Nat.....

1st 24 hrs. after shot.....

Gas..... Cu. Ft.

Dry Hole.....

Abandoned.....

Date

APR 22 1931

192

CHAS. L. SHERWOOD

Scout

no more work

Returned.....	
Cards.....	<i>AB</i>
Tracing.....	<i>CBK</i>
Finance Map.....	<i>X</i>
Scarborough Map.....	<i>X</i>
Moody Map.....	
Scarborough Plat Book.....	
Moody Plat Book.....	

Rice

46 KANSAS Sec. 3 Twp. 19 R. 10^W

Well No. 1 Zink

Solar Oil Co Company

Contractor

CORRECTION

SECTION PLAT

Ft. from N. Line

330 Ft. from S. Line

330 Ft. from E. Line

Ft. from W. Line

	0		

Location *Rog*

Rig up

Drilling and Remarks:

*Chy farm
name to be changed*

RECORD

Cased..... in., ft.

Sand.....

Gas.....

Oil.....

Total Depth.....

PRODUCTION

1st 24 hrs. Nat.....

1st 24 hrs. after shot.....

Gas..... Cu. Ft.

Dry Hole.....

Abandoned.....

Date

MAY 13 1931

CHAS. L. SHERWOOD

192..... Scout

June 1891

Returned	<i>[Signature]</i>
Cards	
Tracing	<i>[Signature]</i>
France Map	X
Scarborough Map	X
Moody Map	X
Scarborough Plat Book	
Moody Plat Book	