FORM 51 5M BRIX KANSAS McPherson County

Section 3 Township 19 Range 2W

Well No. #1 Pitts

Company Phil-Han et al

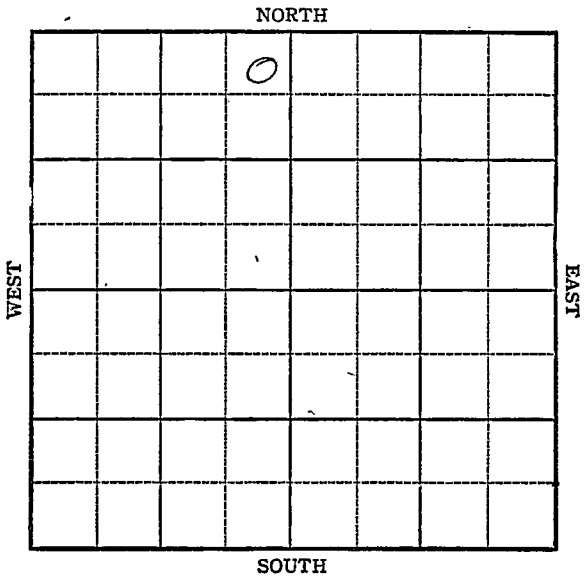

FORM 252-A
5M 9-44 PETROL

KANSAS McPherson County

Sec. 3 Twp. 19 R. 2W

Well No. #1 Pitts Farm

Phil-Han et al Company

Ritz-Canton

330 Ft. from N. Line

Ft. from S. Line

330 Ft. from E. Line

Ft. from W. Line

NE NW

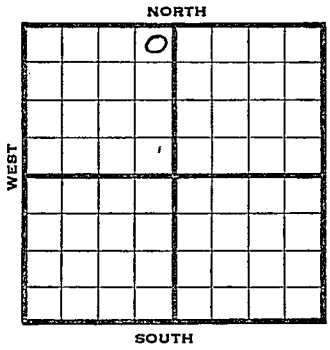

1944	REPORT
10/18	8" @ 248 WOC
10/25	Lans 2350 - Drlg. 2394
11/1	Miss. 2946 TD 2996 No shows.
	ABANDONED

FORM 26 200 BKS. 2-44 PETROL

KANSAS

Pool Name Ritz-Canton

Map No. 43 Sec. 3 Twp. 19 R. 2W

Well No. 1 Pitts

Phil-Han etal Company

FIRST REPORT Contractor

NE NW

SECTION PLAT

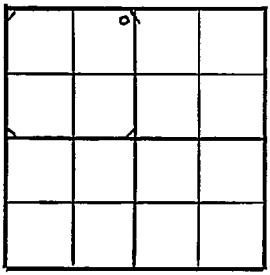

330 Ft. from N. Line

Ft. from S. Line

330 Ft. from E. Line

Ft. from W. Line

McPherson

Location

Rig up

Drilling and Remarks:
8" -248 WOC

RECORD

Cased in, ft.

Sand

Gas

Oil

Total Depth

PRODUCTION

1st 24 hrs. Nat.

1st 24 hrs. after shot

Gas Cu. Ft.

Dry Hole

Abandoned

Date

OCT 1 8 1944 19 S. J. LEWIS Scout

FORM 56 200 BKS, 1-44 PETROL

Pool Name Ritz-Canton

Map No. 43 Sec. 3 Twp. 19 R. 2W

Well No. 1 Pitts

Phil-Han etal. Company

ABANDONED Contractor

NE NW

SECTION PLAT

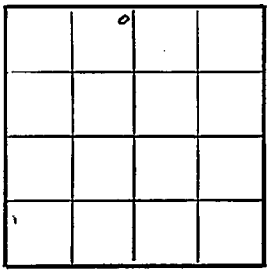

330 Ft. from N. Line

Ft. from S. Line

330 Ft. from E. Line

Ft. from W. Line

McPherson

Location

Rig up

Drilling and Remarks:

Miss 2946

No show

RECORD

Cased in., ft.

Sand

Gas

Oil

Total Depth 2996

PRODUCTION

1st 24 hrs. Nat.

1st 24 hrs. after shot

Gas Cu. Ft.

Dry Hole

Abandoned

Date

NOV 1 1944 19

S. J. LEWIS Scout