

DX 78-1

McPherson


KANSAS

Section 3 Township 19 S Range 2 W

Well No. # 1 Nelson

Company Mallard & Pack

NORTH

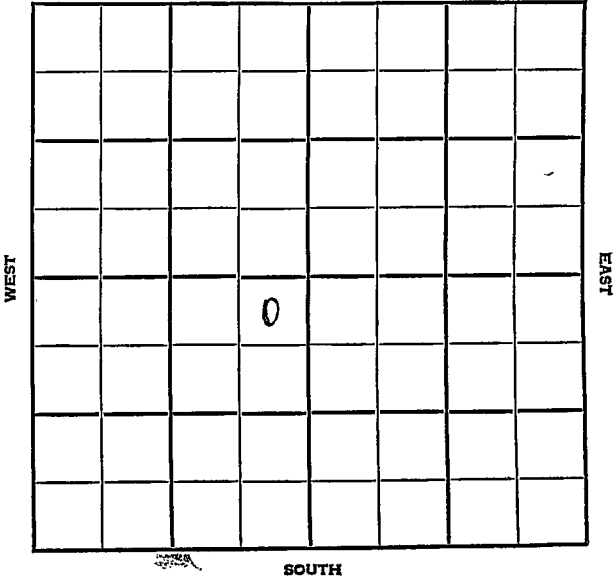

McPherson

KANSAS

SEC.	TWP.	R.
3	19S	2W

WELL NO.

#1 Nelson

FARM

COMPANY

Mallard & Pack

CONTRACTOR

Mallard Tools.

Wildcat.

330

Ft. from N. Line

Ft. from S. Line

330

Ft. from E. Line

Ft. from W. Line

NORTH

			0				

WEST

EAST

SOUTH

NE NE SW
NCRA (Support)

1954

ELEVATION
1563'

REPORT

12/8

Spud 12-1-54

8' @ 155'

KC 2334'

Fshg @ 2611'

12/15

Spud 12-1-54

D & A

TD 2971'

8" @ 155'

KC 2334' Miss 2944'


TD 2956'

5" @ 2953'

DD 2971' FU 800' s.w. scum oil
16hr.

D & A

ABANDONED

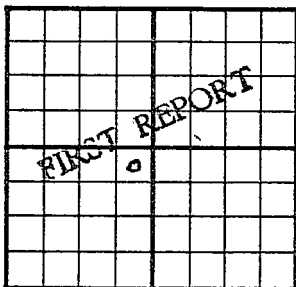County McPherson State KansasSec. 3 (Blk. 19S Twp.) (Sur. 2W Rge.) Map No.Operator Mallard & PackWell No. 1 Farm NelsonElev. Location NE NE SW330 Ft. From N Line330 Ft. From E Line SW Quarter1st. Report DEC 8 1954

Completion

Remarks Mallard toolsNCRA (Support)Spudding Date 12-1-54Drlg. Data Wildcat8" @ 155, KC 2334, Pshg @ 2611

FABEN GILSTRAP

