


Map No. KANSAS Sec. 3 Twp. 19 R. 2^w
Well No. 1- Russell Farm
Olson & Shell Company

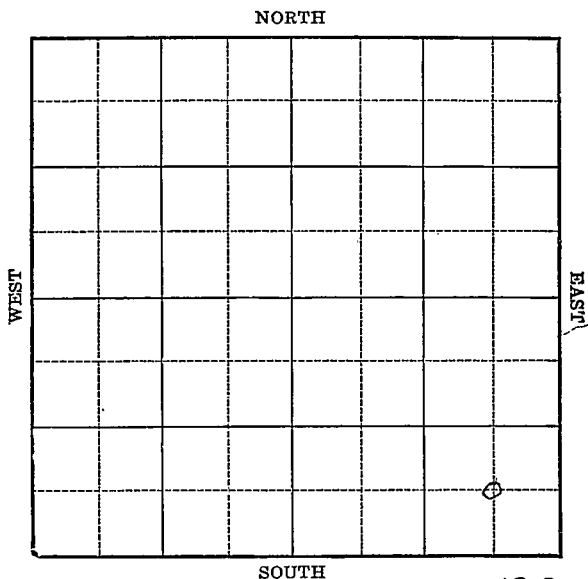

OWDD

Location _____
Drilling Remarks _____

Rig Up _____
Drilling Remarks _____

RECORD


Cased _____ in. _____ ft.
Sand _____
Gas _____
Oil _____
Total Depth _____

PRODUCTION

1st 24 hrs. Nat. _____
1st 24 hrs. after shot _____
Gas _____ cu. ft.
Dry Hole _____
Abandoned _____

Map No. KANSAS Sec. 3 Twp. 19 R. 2^w
Well No. 1- Russell Farm
Olsen & Shell Company

NORTH

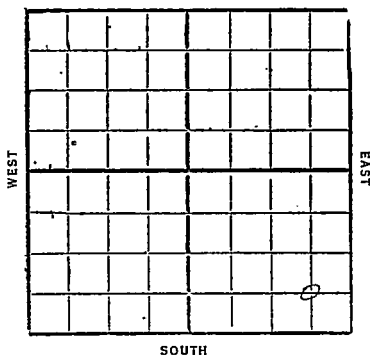

 Ft. from N. Line

660 Ft. from S. Line

660 Ft. from E. Line

1931 Ft. from W. Line

Date

REPORT

OWDD

1/28	Log
2/4	ROS.
2/11	Run up
2/18	Drill 1066'
2/25	" 2560'
3/4	Top Chat 2927
	T.D. 2930' Rust
3/11	Chat 2927-56
3/18	T.D. 2956
	9 2/3 M gas
	895# R.P.
	Comp.
1934	OWDD
6/20	OTD 2956 dly 2961
6/28	—
7/5	Chat 2927 TD 3003 1800 W + 50
7/12	8" 3003
7/19	dly 3115 6" 3111
7/26	M. Min 3130 TV 3409-10
	350' Water
8/2	PA 2958 2 m the. OVER-

8/1 PB 2958. 2 m Gas

8/15- Top Viola 3409

H.F.W @ 3410 T.D. 3410

P.B. to 2958

2 m Gas

COMPLETED

Map No. KANSAS Sec. 3 Twp. 19 R. 2 W.

Well No. 43
1 Russell

Olsen & Shell Company

Contractor

SECTION PLAT

..... Ft. from N. Line

660 Ft. from S. Line

660 Ft. from E. Line

..... Ft. from W. Line

			0

REPORT

Location ✓

Rig up

Drilling and Remarks:

RECORD

Cased..... in., ft.

Sand.....

Gas.....

Oil.....

Total Depth.....

PRODUCTION

1st 24 hrs. Nat.....

1st 24 hrs. after shot.....

Gas..... Cu. Ft.

Dry Hole.....

Abandoned.....

Date

JAN 28 1931

S. J. LEWIS Scout

Small map
watering

Returned	
Cards	<i>RTG</i>
Tracing	<i>ASX</i>
Francis Map	<i>X</i>
Scarborough Map	<i>SP</i>
Moody Map	<i>X</i>
Scarborough Flat Book	
Moody Flat Book	

Map No. KANSAS Sec. 3 Twp. 19 R. 2 W

Well No. 43 1 Russell

Olson & Shell Company

Contractor

SECTION PLAT

Ft. from N. Line

660 Ft. from S. Line

660 Ft. from E. Line

Ft. from W. Line

			0

COMPLETED

Location

Rig up

Drilling and Remarks:

895' Rock
Pressure

RECORD

Cased in, ft.

Sand 2927-2956

Gas 9 2/3 M

Oil

Total Depth 2956

PRODUCTION

1st 24 hrs. Nat.

1st 24 hrs. after shot

Gas Cu. Ft.

Dry Hole

Abandoned

Date

MAR 1 8 1931 192

S. J. LEWIS Scout

Small
waiver

Returned	
Cards	
Tracing	
France Map	
Scarborough Map	
Moody Map	
Scarborough Plat Book	
Moody Plat Book	

Map No. 43 Sec. 3 Twp. 19 R. 2WWell No. 1-RussellOlson & Shell Company

Contractor

FIRST REPORT

Ft. from N. Line

660 Ft. from S. Line660 Ft. from E. Line

Ft. from W. Line

SECTION PLAT

			0

Location _____

Rig up _____

Drilling and Remarks:

OTD 2956Alg 2961**RECORD**

Cased _____ in., _____ ft.

Sand _____

Gas _____

Oil _____

Total Depth _____

PRODUCTION

1st 24 hrs. Nat. _____

1st 24 hrs. after shot _____

Gas _____ Cu. Ft.

Dry Hole _____

Abandoned _____

Date

6-20-37 19**ORVAL MANNSCHRECK**

Scout

sw
wall map

Returned	
Cards	<i>pp</i>
Tracing	<i>nws</i>
France Map	✓
Co 1 to 5 Map	✓
Moody Map	

 Map No. 43 Sec. 3 Twp. 19 R. 2W
 Well No. 1- Russell
Olson & Shell Company

Contractor

COMPLETED**SECTION PLAT**

			0

 Ft. from N. Line
660 Ft. from S. Line
660 Ft. from E. Line
 Ft. from W. Line

Location Rig up

Drilling and Remarks:

Top Viola 3409
H.F.W 3410.
plug back
2958
2 mil gas

RECORDCased in., ft.Sand Gas Oil Total Depth 3410**PRODUCTION**1st 24 hrs. Nat. 1st 24 hrs. after shot Gas Cu. Ft.Dry Hole Abandoned

Date

8-15-37₁₉**ORVAL MANSCHRECK**

Scout

①

Returned	
Cards	
Tracing	
France Map	
Scarborough Map	
Moody Map	
Scarborough Plat Book	
Moody Plat Book	