




McPherson

Form 252-A  
5M 4-32 MPC

Map No. **KANSAS** Sec. 3 Twp 19 R. 2<sup>W</sup>

Well No. 1 Nelson Farm  
Wolfe Creek Company

\_\_\_\_\_ Ft. from N. Line  
330 Ft. from S. Line  
\_\_\_\_\_ Ft. from E. Line  
330 Ft. from W. Line

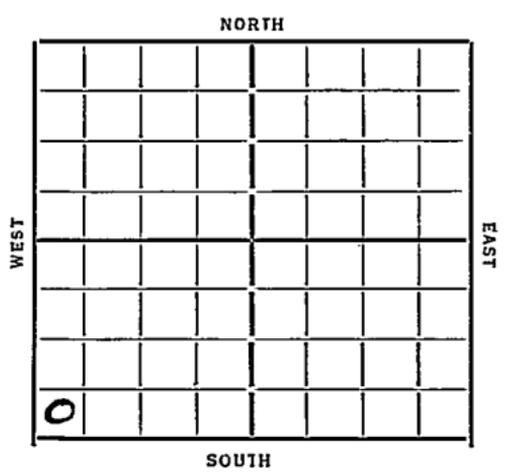

Date  
1934

REPORT

<u>5/16</u>	<u>Cellar</u>	
<u>5/25</u>	<u>—</u>	
<u>5/31</u>	<u>R. U.</u>	
<u>6/7</u>	<u>Alg 628</u>	<u>12 1/2 85</u>
<u>6/14</u>	<u>" 700</u>	
<u>6/21</u>	<u>SD 700</u>	
<u>6/28</u>	<u>Alg 1975</u>	<u>8" 1650</u>
<u>7/5</u>	<u>Rena 6" 2303</u>	
<u>7/12</u>	<u>Alg 2465</u>	<u>14 7/8 2440</u>
<u>7/19</u>	<u>WR 6" 2610</u>	
<u>7/26</u>	<u>WR 6" 2621</u>	
<u>8/2</u>	<u>Chit 2938</u>	<u>Rena 5"</u>
<u>8/8</u>	<u>Chit 2938</u>	<u>TD 3007</u>
	<u>14 7/8</u>	<u>AS A</u>

**ABANDONED**

Map No. 43 Sec. 3 Twp. 19 R. 2W

Well No. 1 - Nelson

Wolfe Creek Company

Contractor

**FIRST REPORTS**

**SECTION PLAT**


\_\_\_\_\_ Ft. from N. Line

330 Ft. from S. Line

\_\_\_\_\_ Ft. from E. Line

330 Ft. from W. Line

Location \_\_\_\_\_

Rig up \_\_\_\_\_

Drilling and Remarks:

*cellar*

**RECORD**

Cased \_\_\_\_\_ in., \_\_\_\_\_ ft.

Sand \_\_\_\_\_

Gas \_\_\_\_\_

Oil \_\_\_\_\_

Total Depth \_\_\_\_\_

**PRODUCTION**

1st 24 hrs. Nat. \_\_\_\_\_

1st 24 hrs. after shot \_\_\_\_\_

Gas \_\_\_\_\_ Cu. Ft.

Dry Hole \_\_\_\_\_

Abandoned \_\_\_\_\_

Date

5-16-31 19

**ORVAL MANNSCHRECK**

Scout

Map No. 43 Sec. 3 Twp. 19 R. 2W

Well No. 1-Nelson  
Wolfe Creek Company

Contractor

ABANDONED SECTION PLAT

         Ft. from N. Line

330 Ft. from S. Line

         Ft. from E. Line

330 Ft. from W. Line

0			

Location \_\_\_\_\_

Rig up \_\_\_\_\_

Drilling and Remarks:

*H F W*  
*10 + H*

RECORD

Cased \_\_\_\_\_ in., \_\_\_\_\_ ft.

Sand Chat 2938

Gas \_\_\_\_\_

Oil \_\_\_\_\_

Total Depth 3007

PRODUCTION

1st 24 hrs. Nat. \_\_\_\_\_

1st 24 hrs. after shot \_\_\_\_\_

Gas \_\_\_\_\_ Cu. Ft.

Dry Hole \_\_\_\_\_

Abandoned \_\_\_\_\_

Date 8-8-37 19

**ORVAL MANNSCHRECK**  
Scout