Barton

KANSAS


FORM 51 10M 12-46 PETROL

Section 3 Township 19 Range 15W

Well No. 5 Saylor

Company Vickers

Ryan

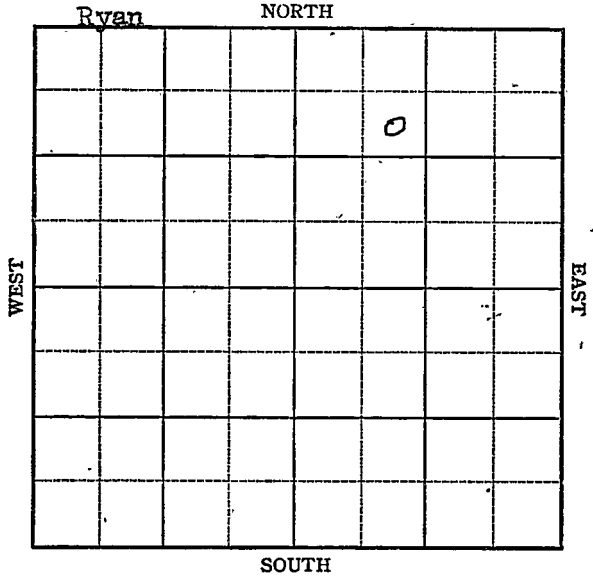

2

FORM 252-A
5M 12-46 PETROL

KANSAS Barton

Sec. 3 Twp. 19 R. 15W

Well No. #5 Saylor Farm

Vickers Company

Ryan


990 Ft. from N. Line

Ft. from S. Line

Ft. from E. Line

990 Ft. from W. Line

SE NW NE

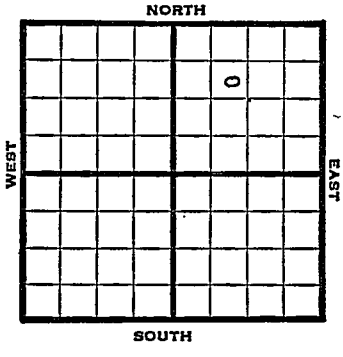

1947	REPORT
	Elev 1936'
7/23	Surface hole.
7/29	Drlg. 2250'
8/6	Lansing 3238' Basal 3543' TD 3552' 5" @ 3545' RUST
8/13	BAsal 3543' T.D. 3555' Abandoned.

ABANDONED

Form 26 200 Bks. 10-46 Petrol

Kansas

Ryan Pool

Map No. _____ Sec. 3 Twp. 19 R. 15W

Well No. 5 Saylor

Vickers Company

FIRST REPORT

Contractor

SE NW NE


990 Ft. from N. Line

_____ Ft. from S. Line

_____ Ft. from E. Line

990 Ft. from W. Line

SECTION PLAT

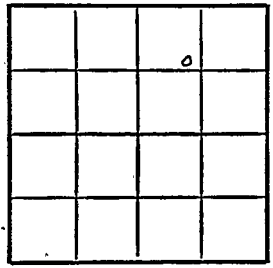

Barton County

Location _____

Rig up _____

Drilling and Remarks:

surface hole

RECORD

Cased _____ in., _____ ft.

Sand _____

Gas _____

Oil _____

Total Depth _____

PRODUCTION

1st 24 hrs. Nat. _____

1st 24 hrs. after shot _____

Gas _____ Cu. Ft.

Dry Hole _____

Abandoned _____

Date

JUL 23 1947 19

S. J. LEWIS Scout

Form 26 200 Bks. 10-46 Petrol

Ryan Pool

Kansas

Map No. 82 Sec. 3 Twp. 19 R. 15W

Well No. 5 Saylor

Vickers Company


ABANDONED

Contractor

SE NW NE

E1/1986

SECTION PLAT

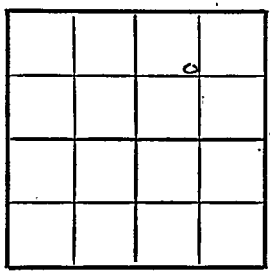

990 Ft. from N. Line

Ft. from S. Line

Ft. from E. Line

990 Ft. from W. Line

Barton County

Location

Rig up

Drilling and Remarks:

Kansas 68543

RECORD

Cased in., ft.

Sand

Gas

Oil

Total Depth 3505'5

PRODUCTION

1st 24 hrs. Nat.

1st 24 hrs. after shot

Gas Cu. Ft.

Dry Hole

Abandoned

Date

AUG 13 1947 19

S. J. LEWIS Scout