

Barton

Section 3 Township 19 Range 15WWell No. 7 SaylorCompany Vickers Alberts Pool

NORTH

				0			

WEST

EAST

SOUTH

2

KANSAS

Barton

Sec. 3 Twp. 19 R. 15W ✓Well No. #7 Saylor Farm


Vickers

Company

Alberts Pool

330' Ft. from N. Line Ft. from S. Line Ft. from E. Line330' Ft. from W. Line

NW NE

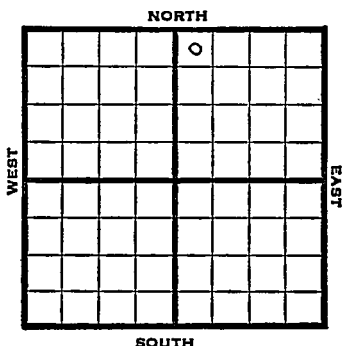

1948

Elev. 1952' REPORT

9/8

8" @ 935'

WOC

9/14

Drlg 3200'

9/21

Lansing 3245'

Drlg 35225'

9/29

Basal Sd 3554'

5" @ 3544'

Pump 75 oil Pot.

Gr. 36°

TD 3564'

COMPLETED

Barton County Kansas State

Map No. _____ Sec. 3 Twp. 19 R. 15W

Well No. 7 Saylor

Vickers Company

FIRST REPORT Contractor

NW NE

SECTION PLAT

				o			

330 Ft. from N. Line

_____ Ft. from S. Line

_____ Ft. from E. Line

330 Ft. from W. Line

Alberts Pool

Remarks:

8" @ 935 WOC

Date
SEP 8 1948

Scout
S. J. LEWIS

Map No. 82 Sec. 3 Twp. 19 R. 15W

Well No. 7 Saylor

Vickers Company

COMPLETE

Contractor

NW NE

E 11952

SECTION PLAT

		o	

330 Ft. from N. Line

Ft. from S. Line

Ft. from E. Line

330 Ft. from W. Line

Barton County

Location

Rig up

Drilling and Remarks:

Base 6. Col 3554

5" 35544

Prod 75 Oil Prod

36 5/8

RECORD

Cased 6 in., 1 ft.

Sand

Gas

Oil ☒

Total Depth 3564

PRODUCTION

1st 24 hrs. Nat.

1st 24 hrs. after shot

Gas Cu. Ft.

Dry Hole

Abandoned

Date

SEP 29 1948

19

S. J. LEWIS

Scout