

KANSAS


Form 51-5M-7-40-Palace

Barton

Section 3 Township 19 Range 13-W

Well No. #1 Benjamin

Company W. O. Allen et al

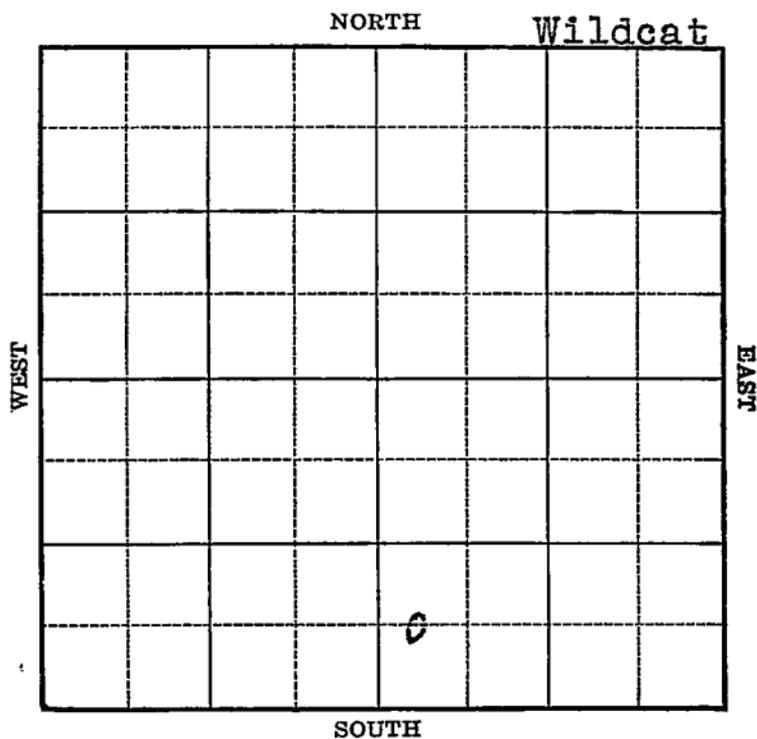

Sec. 3 Twp. 19 R. 13-W

Well No. #1 Benjamin Farm

W. O. Allen et al Company

(Wildcat)


_____ Ft. from N. Line

660 Ft. from S. Line

_____ Ft. from E. Line

330 Ft. from W. Line

Elev. 1898

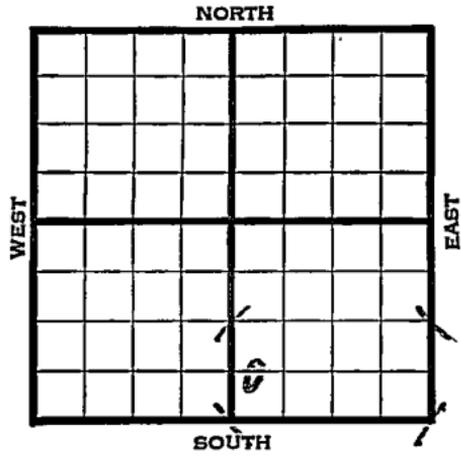

REPORT

1940	
11/6	Location
11/14	"
11/21	Derrick.
11/27	10" - 390' Anhy 778'
	Drlg. 1120'
12/5	Ft. Riley 1830' Florence 1930'
	Drlg. 2858'
12/11	Topeka 2850'
	Lans. 3205'
	Cong. 3434'
	Arb. 3449'
	T.D. 3485'
	No shows.

ABANDONED

Map No. 82 Sec. 3 Twp. 19 R. 13WWell No. 1 BenjaminW. O. Allen etal Company

Contractor

FIRST REPORT

C W L SW SE

 Ft. from N. Line660 Ft. from S. Line Ft. from E. Line330 Ft. from W. Line**SECTION PLAT**

WILDCAT

Location XRig up

Drilling and Remarks:

RECORDCased in., ft.Sand Gas Oil Total Depth **PRODUCTION**1st 24 hrs. Nat. 1st 24 hrs. after shot Gas Cu. Ft.Dry Hole Abandoned

Date

NOV 6 1940 19S. J. LEWIS Scout

Map No. 82 Sec. 3 Twp. 19 R. 13WWell No. 1 BenjaminW. O. Allen etal Company

Contractor

ABANDONED

C W L SW SE

 Ft. from N. Line660 Ft. from S. Line Ft. from E. Line330 Ft. from W. Line**SECTION PLAT**

WILDCAT

Location Rig up

Drilling and Remarks:

Topoka 2850
Wase 3205
Cong 3434
GLY 3449
Wichita

RECORDCased in., ft.Sand Gas Oil Total Depth 3485**PRODUCTION**1st 24 hrs. Nat. 1st 24 hrs. after shot Gas Cu. Ft.Dry Hole Abandoned

Date

DEC 11 1940 19 S. J. LEWIS Scout