


DX 78-1

Barton KANSAS

Section 3 Township 19 Range 13W

Well No. 1 Benjamin

Company V. E. Autry

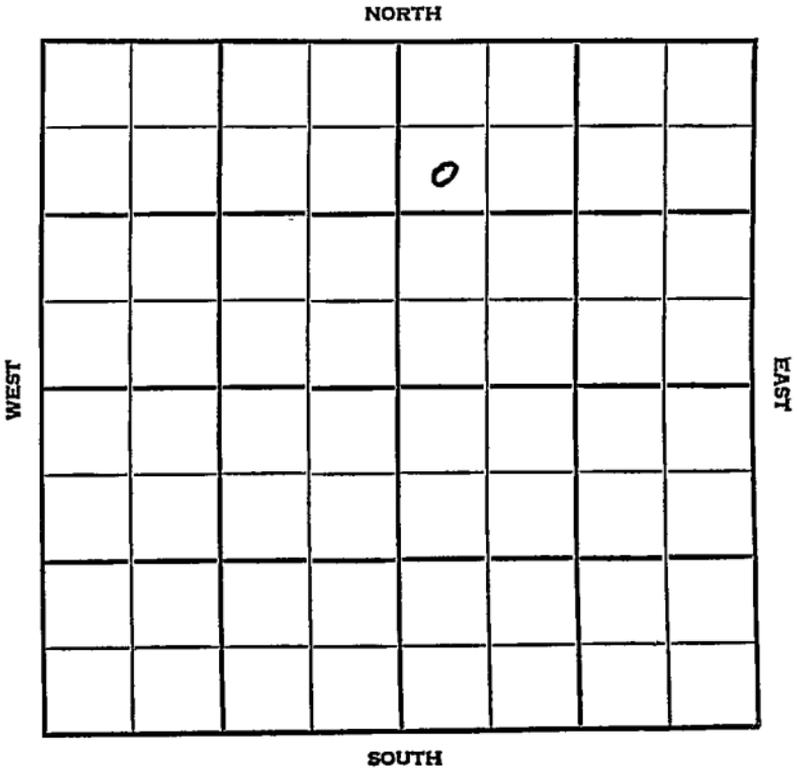

Barton

KANSAS

SEC.	TWP.	R.
3	19	13 W

WELL NO. _____

COMPANY # 1 Benjamin FARM

CONTRACTOR V. E. Autry

K & E Drlg.

Wildcat


990 _____ Ft. from N. Line

_____ Ft. from S. Line

_____ Ft. from E. Line

330 _____ Ft. from W. Line

SW NW NE

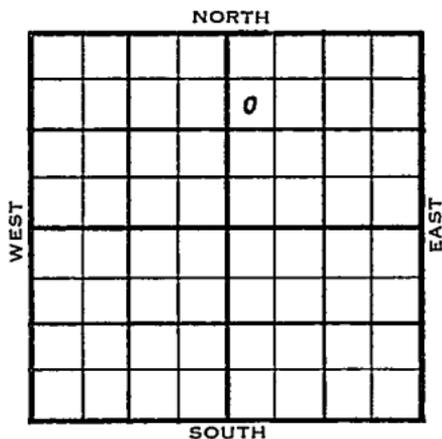

	ELEVATION	REPORT
1954	1883'	

12/15

Location

1955

2/9

Spud 12-17-54
 Oil Well
 TD 3415'
 8" @ 240'
 Heeb 3063', Br. Lime 3156' Lans 3170'
 DST 3159'-3204' opn 1 hr, rec 2400'
 gas, 70' socm, 60' o & gcm 120' ho &
 gcm 60' o & vhocm 640#
 Cong 3403' Arb. 3414'
 TD 3415'
 5" @ 3413' HFW
 PB 3266
 24/ 3170-80 26/ 3186-96 24/ 3200-06
 1000 A P/ 138 bopd.
 Comp 85 bopd.

COMPLETED

