


Section **3** Township **19** Range **26 W**

Well No. **# 1 Pemeler**

Company **Wedell et al**

*16*

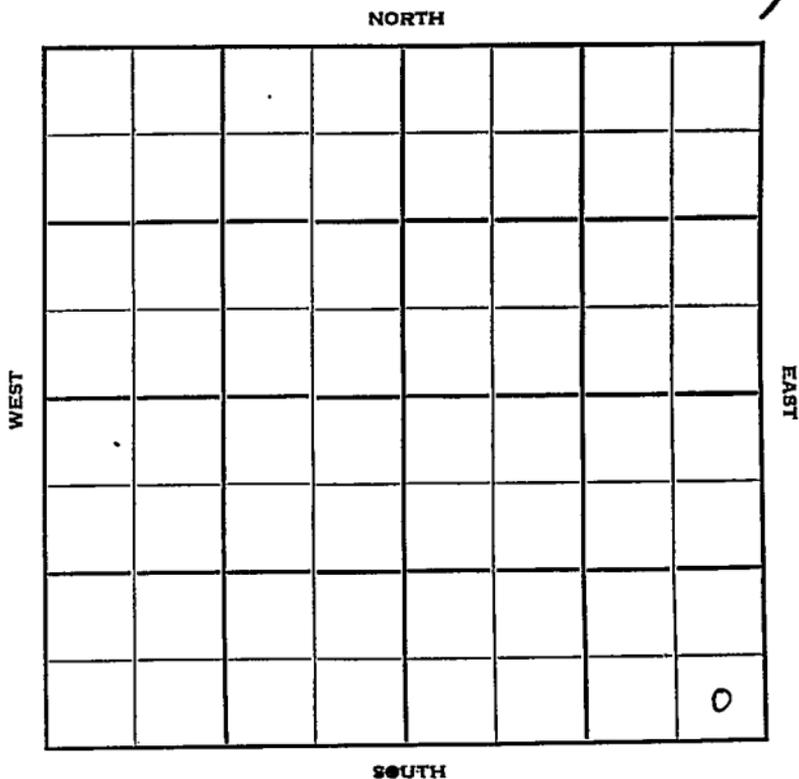

Sec. 3 Twp. 19 R. 26W

Well No. #1 Pemeler Farm

Wedell et al Company

Burwick - Contr. Contractor

Wildcat


\_\_\_\_\_ Ft. from N. Line

330' Ft. from S. Line

330' Ft. from E. Line

\_\_\_\_\_ Ft. from W. Line

SE SE SE

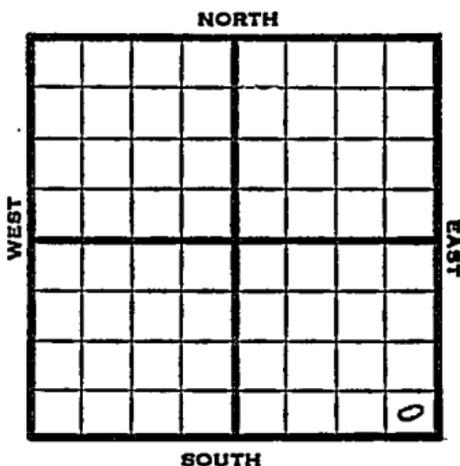

1951

Elev. 2571' REPORT

7/3 Location

7/25 Spud 7-7-51

D & A TD 4651' 8" @ 236

Heeb 3888' Lans. 3928' Mar. 4438

Miss. dol. 4551'

TD ~~4~~651' D & A

**ABANDONED**

County Ness State Kansas

Sec. 3 (Blk. 19 (Sur. Rge.) 26W Map No.

Operator Wedell - etal

Well No. 1 Farm Pemeter

Elev. \_\_\_\_\_ Location SE SE SE

							0

FIRST REPORT

330 Ft. From S Line SE

330 Ft. From E Line Quarter

Ist. Report JUL 3 1951

Completion \_\_\_\_\_

Remarks Gulf - B.H.M.

Burwick - Contr.

Spudding Date \_\_\_\_\_

Drlg. Data Wildcat

Location

J. E. TYRA

