


Lane

Section 3 Township 19 Range 30-W

Well No. 1 John Kees


Company Phillips

16

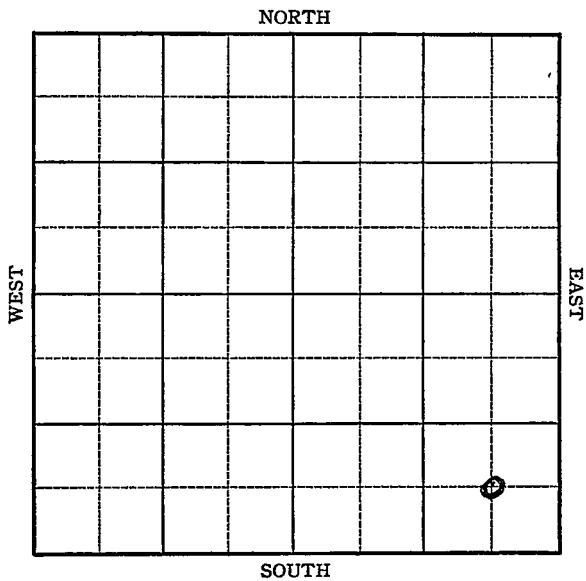

Sec. 3 Twp. 19 R. 30-WWell No. #1 John Kees FarmPhillips Company Ft. from N. Line660 Ft. from S. Line660 Ft. from E. Line Ft. from W. Line

Elev. 2875

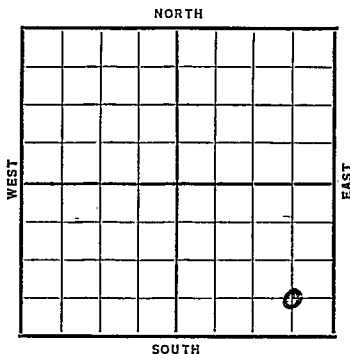

Date	REPORT
1937	
12/8	B. R. R.
12/17	R U R
12/24	12" @ 245'.
	Drlg. 545'.
12/31	Drlg. 2545'.
1938	
1/7	Drlg. 3040'.
1/14	Anhy 2187'. Drlg. 3710'.
1/20	Topeka 3690' T.D. 3957'
	Drill pipe stuck.
1/22	Top Kans'as City 4075'.
	Cored 4091-4103', recovered 12'
	porous lime.
	Small show oil ??
1/28	Drlg. 4256' no shows.
2/12	Top Miss 4582' T.D. 4753
	Going to Siliceous Lime (tel)
2/11	Miss. 4582'. T.D. 4763'.
	S.D.O. No shows.
2/18	T.D. 4885'. Lost circulation Shut down.

OVER

Map No. NM Sec. 3 Twp. 19 R. 30W

Well No. 1 John Kees

 Phillips Company

Contractor

FIRST REPORT

SECTION PLAT

C SE SE

_____ Ft. from N. Line

660 Ft. from S. Line

660 Ft. from E. Line

_____ Ft. from W. Line

Special

			0

Location _____

Rig up _____

Drilling and Remarks:

BRR

RECORD

Cased _____ in., _____ ft.

Sand _____

Gas _____

Oil _____

Total Depth _____

PRODUCTION

1st 24 hrs. Nat. _____

1st 24 hrs. after shot _____

Gas _____ Cu. Ft.

Dry Hole _____

Abandoned _____

Date

DEC 8 - 1937 19

H. D. Hatfield

Scout

Lane

KANSAS

Map No. N 13 Sec. 3 Twp. 19 R. 30WWell No. 1 John KeesPhillips Company

Contractor

ABANDONED

C SE SE

SECTION PLAT

 Ft. from N. Line660 Ft. from S. Line660 Ft. from E. Line Ft. from W. Line

			0

Location Rig up

Drilling and Remarks:

LOST CIRCULATIONDVA

RECORD

Cased 7 in., 2483 ft.Sand MISS 4582Gas Oil Total Depth 4911

PRODUCTION

1st 24 hrs. Nat. 1st 24 hrs. after shot Gas Cu. Ft.Dry Hole Abandoned

Date

JUL 6 - 1938

19

H. D. Hatfield Scout

1938

2/26 T.D. 4885'. Lost circulation
Shut down.

3/4--T.D. 4893'. Cementing cave.

3/11---T.D. 4911'. 10" @ 1444'. WOG.

3/18 " " " " "

3/25 Cementing cave.

4/1 TD 4911' SD.

4/8 Fighting cave.

4/15 " " "

4/22 " " "

4/29 " " "

5/6 " " "

5/12 " " "

5/20 " " "

5/27 7" @ 2483'. T.D. 2563'.
Lost circulation.

6/3 " " " "

6/10 " " " "

6/17 " " " "

6/24 " " " "

7/1 Shut down

7/6 7" @ 2483'.
Miss. 4582'.
T. D. 4911'.
Lost circulation.

ABANDONED