


Section 30 Township 19 Range 11WWell No. #2 RothCompany W. L. Hartman

NORTH

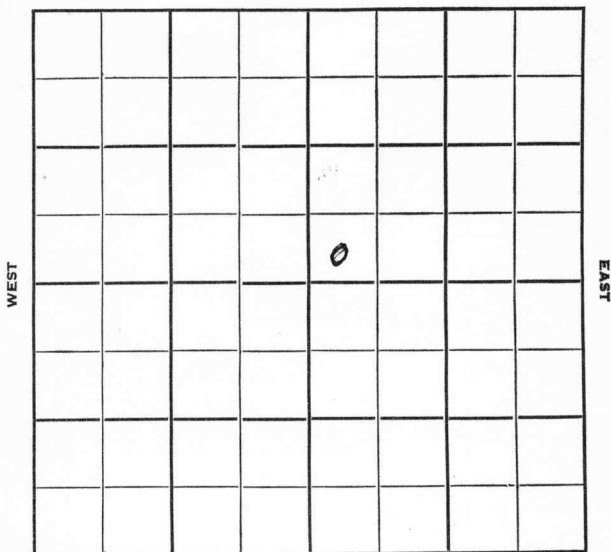

SOUTH

Barton

KANSAS

Sec. 30 Twp. 19 R. 11W ✓

Well No. #2 Roth Farm

W. L. Hartman Company

Contractor

Werner


Ft. from N. Line

330 Ft. from S. Line

Ft. from E. Line

330 Ft. from W. Line

SW SW NE

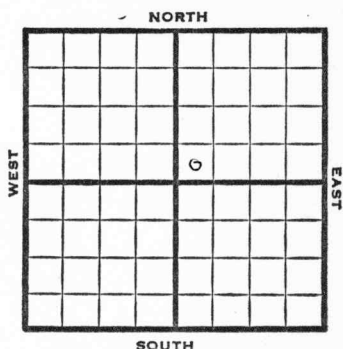

1951

Elev. 1797'

REPORT

11/14

Spud 11-8-51
8" @ 192
Drlg. 2865'

1952
2/6

TD 3374
5" @ 3366'

2/13
2/20


No report
"

3/5

Spud 11-8-51
Oil well TD 3374' 8" @ 192'
Top 2693'
DST 2893-2918' open 1 hr, rec 25' mud.
Heeb 2956'
DST 2968-90 open $\frac{1}{2}$ hr, rec 10' mud
Br. lime 3076' Lans. 3091'
DST 3076-3102 open 1 hr, rec 15' mud
DST 3105-25 open 1 hr. rec 15' mud
DST 3131-58 open 1 hr. rec 12' mud
DST 3158-72 open 1 hr. rec 35' mud
DST 3174-90 open 1 hr. rec 18' mud
DST 3121-37 open $\frac{1}{2}$ hr. rec 4' mud
DST 3254-76 open 1 hr. rec 15' mud
5" @ 3366 TD 3374'
Cong. 3350' Arb. 3364-74'
DST 3364-67 open $\frac{1}{2}$ hr, rec 12' mud
DST 3367-74 open 1 hr. rec 15' mud
Comp. 15 BOPD

COMPLETED

County **Barton** State **Kansas**
 Sec. **30** (Blk.) **19** (Sur.) **11W** Map No.
 (Twp.)
 Operator **W. L. Hartman**
 Well No. **2** Farm **Roth**
 Elev. Location **SW SW NE**

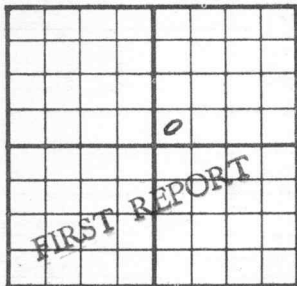

330 Ft. From **S** Line **NE**

330 Ft. From **W** Line Quarter

1st. Report **NOV 14 1951**

Completion

Remarks

Spudding Date **11-8-51**

Drlg. Data

Werner

8" @ 192 Drlg. 2865

J. E. TYRA

County Barton State Kansas
 Sec. 30 (Blk. 19) (Sur. 11W) (Twp. Map No.)
 Operator W. L. Hartman
 Well No. 2 Farm Roth
 Elev. 1797 Location SW SW NE

COMPLETE

0

330 Ft. From S Line NE

330 Ft. From W Line Quarter

1st. Report

Completion **MAR 5 1952**Remarks Werner PoolSpudding Date 11-8-51Drilg. Data Oil well TD 3374

8" @ 192 Top. 2693 DST 2893-2918

open 1 hr. Rec. 25' mud Heeb. 2956

DST 2968-90 open $\frac{1}{2}$ hr. Rec. 10' mud

Br. lime 3076 Lans. 3091 DST 3076-3102

open 1 hr. Rec. 15' mud DST 3105-25

open 1 hr. Rec. 15' mud DST 3131-58

open 1 hr. Rec. 12' mud DST 3158-72

open 1 hr. Rec. 35' mud DST 3174-90

open 1 hr. Rec. 18' mud DST 3121-37

open $\frac{1}{2}$ hr. Rec. 4' mud DST 3254-76

open 1 hr. Rec. 15' mud 5" @ 3366

TD 3374 Cong. 3350 Arb. 3364-74

DST 3364-67 open $\frac{1}{2}$ hr. Rec. 12' mud

DST 3367-74 open 1 hr. Rec. 15' mud

Comp. 15 bopd

J. G. McGEHEE