

KANSAS


Barton

FORM 51 5M 4-41 PETROL

Section 30 Township 19 Range 11-W

Well No. #1 Roth

Company Helmerich & Payne & Phillips

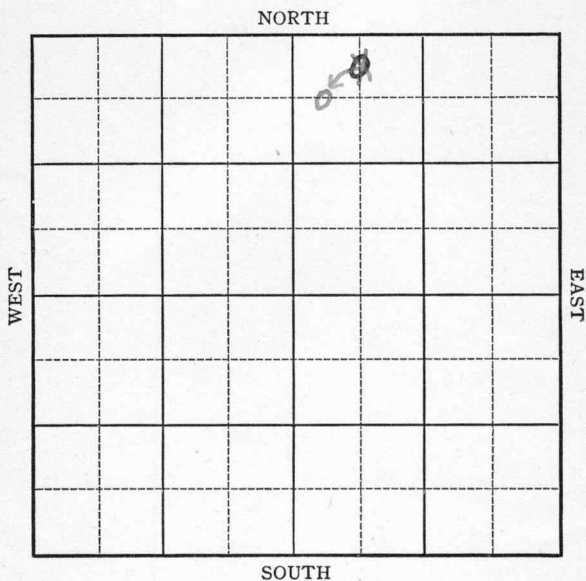

Map No. 46 Sec. 30 Twp. 19 R. 11WWell No. 1 RothHelmerich & Payne & Phillips
Company

Contractor

FIRST REPORT

330 0 N L NW NE
Ft. from N. Line


____ Ft. from S. Line

____ Ft. from E. Line

660 Ft. from W. Line

SILICA POOL

SECTION PLAT

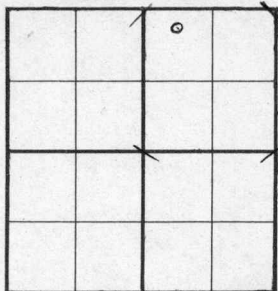

Location _____

Rig up _____

Drilling and Remarks:

Rotary

RECORD

Cased _____ in., _____ ft.

Sand _____

Gas _____

Oil _____

Total Depth _____

PRODUCTION

1st 24 hrs. Nat. _____

1st 24 hrs. after shot _____

Gas _____ Cu. Ft.

Dry Hole _____

Abandoned _____

Date

JUN 4 1941

19

S. J. LEWIS

Scout

Map No. 46 Sec. 30 Twp. 19 R. 11WWell No. 1 RothHelmerich & Payne and Phillips
Company

CORRECTION

Contractor

SECTION PLAT

C W L NW NE

660 Ft. from N. Line

_____ Ft. from S. Line

_____ Ft. from E. Line

330 Ft. from W. Line

WILDCAT

		o	

Location _____

Rig up _____

Drilling and Remarks:

Reported

C N L NW NE

RECORD

Cased _____ in., _____ ft.

Sand _____

Gas _____

Oil _____

Total Depth _____

PRODUCTION

1st 24 hrs. Nat. _____

1st 24 hrs. after shot _____

Gas _____ Cu. Ft.

Dry Hole _____

Abandoned _____

Date

JUN 11 1941 19S. J. LEWIS Scout

Map No. _____ Sec. 30 Twp. 19 R. 11WWell No. 1 Roth
Helmerich & Payne and Phillips
Company

Contractor _____

ABANDONED

SECTION PLAT

		Δ	

C W L NW NE

660 Ft. from N. Line

_____ Ft. from S. Line

_____ Ft. from E. Line

330 Ft. from W. Line

WILDCAT

RECORD

Location _____

Cased _____ in., _____ ft.

Rig up _____

Sand _____

Drilling and Remarks:

Gas _____

Oil _____

*At 330.7**5" 3375.**Water*Total Depth 3404

PRODUCTION

1st 24 hrs. Nat. _____

1st 24 hrs. after shot _____

Gas _____ Cu. Ft.

Dry Hole _____

Abandoned _____

Date

JUL 9 1941 19 S. J. LEWIS Scout