

Barton

KANSAS

Section 30 Township 19 Range 11W

Well No. #1 Roth

Company W.L. Hartman

NORTH

				0			

WEST

EAST

SOUTH

Barton

KANSAS

Sec. 30 Twp. 19 R. 11W

Well No. #1 Roth Farm

W. L. Hartman Company

Contractor


330' Ft. from N. Line

_____ Ft. from S. Line

_____ Ft. from E. Line

330' Ft. from W. Line

NW NW NE

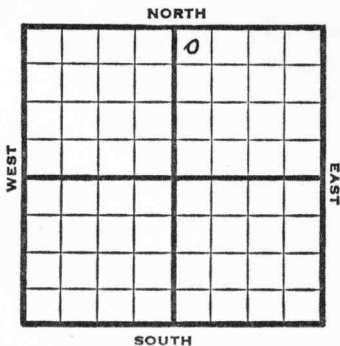

1951

Elev. 1793' REPORT

1/24

Location

5/16

Abandoned location

ABANDONED

County **Barton** State **Kansas**

Sec. **30** (Blk. Twp.) **19** (Sur. Rge.) **11W** Map No.

Operator **W. L. Hartman**

Well No. **1** Farm **Roth**

Elev. Location **NW NW NE**

		0		

330 Ft. From **N** Line **NE**
330 Ft. From **W** Line Quarter

1st. Report **JAN 24 1951**

Completion

Remarks

Spudding Date

Drig. Data

Location

J. E. TYRA

County Barton State Kansas

Sec. 30 (Blk. 19 (Sur. Rge.) 11W Map No.

Operator W. L. Hartman

Well No. 1 Farm Roth

Elev. 1793 Location NW NW NE

ABANDONED

330 Ft. From N Line NE

330 Ft. From W Line Quarter

1st. Report

Completion MAY 16 1951

Remarks

Spudding Date

Drlg. Data

Abd. location

J. E. TYRA