

KANSAS


Rice

FORM 51 5M 10-41 PETROL

Section 30 Township 19 Range 10-W

Well No. #1 Roth

Company Colorado Petr.

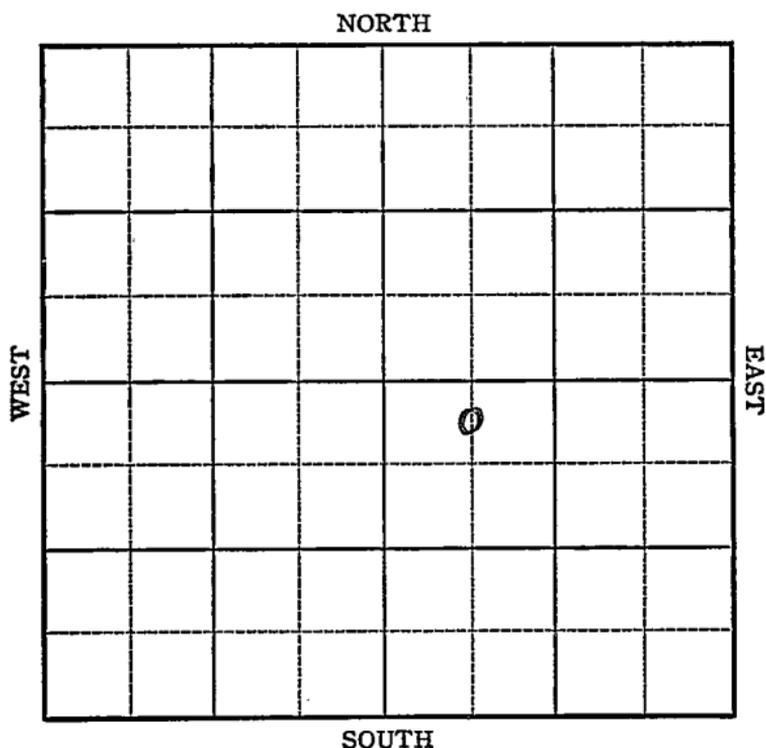

Map No. 46 Sec. 30 Twp. 19 R. 10WWell No. 1 RothColorado Petroleum Company**FIRST REPORT**


Contractor

SECTION PLAT

C NL NW SE
330 Ft. from N. Line

_____ Ft. from S. Line

_____ Ft. from E. Line

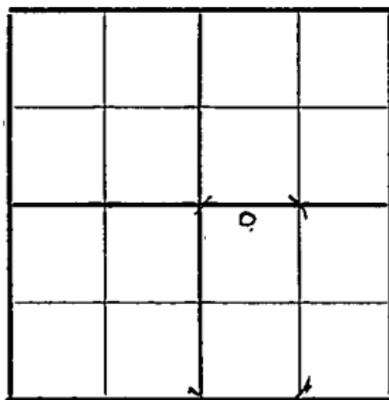660 Ft. from W. Line

SILICA POOL

Location _____

Rig up _____

Drilling and Remarks:

Rotary _____

RECORD

Cased _____ in., _____ ft.

Sand _____

Gas _____

Oil _____

Total Depth _____

PRODUCTION

1st 24 hrs. Nat. _____

1st 24 hrs. after shot _____

Gas _____ Cu. Ft.

Dry Hole _____

Abandoned _____

Date

MAY 6 1942 19S. J. LEWIS Scout

Rice

KANSAS

Map No. 46 Sec. 30 Twp. 19 R. 10W

Well No. 1 Roth

Colorado Petroleum Company

ABANDONED Contractor

C NL NW SE

SECTION PLAT

330 Ft. from N. Line

_____ Ft. from S. Line

_____ Ft. from E. Line

660 Ft. from W. Line

		o	

SILICA POOL

Location _____

Rig up _____

Drilling and Remarks:

*CE 43319
5" @ 3319
5000 cu ft
Water.*

RECORD

Cased _____ in., _____ ft.

Sand _____

Gas _____

Oil _____

Total Depth 3330

PRODUCTION

1st 24 hrs. Nat. _____

1st 24 hrs. after shot _____

Gas _____ Cu. Ft.

Dry Hole _____

Abandoned _____

Date

JUN 3 1942 19

S. J. LEWIS Scout