

**KANSAS**


FORM 51 5M BR1X

Rice

Section 50 Township 19 Range 10W

Well No. #1 E-Roth

Company Mouser Drlg

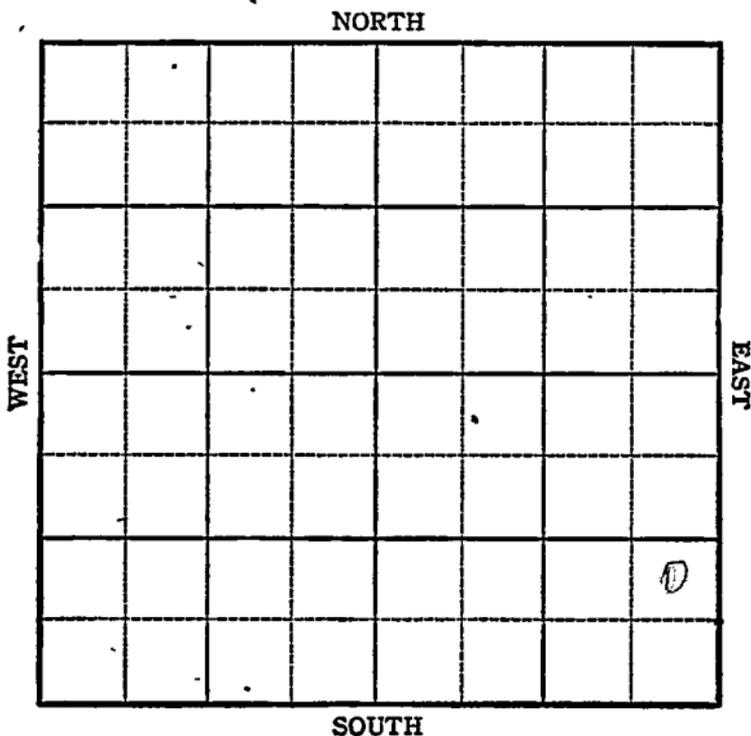

KANSAS

Rice

Sec. 30 Twp. 19 R. 10W

Well No. #1 E Roth Farm

Mouser Drlg. Company


Silica

\_\_\_\_\_ Ft. from N. Line

990 \_\_\_\_\_ Ft. from S. Line

330 \_\_\_\_\_ Ft. from E. Line

\_\_\_\_\_ Ft. from W. Line

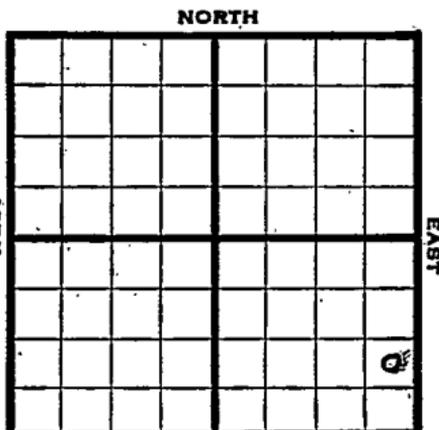

NE SE SE *6* *1783*

1944

REPORT


8/23	8" @ 156	WOC
8/30	Anhy' 499	
	Drlg. 2526	
9/8	Arb. 3311	137D SO
	5" @ 3214	RUST
9/13	" " " " " "	
9/21	TD 3314 - 2600	oil
9/28	" " " " "	
10/4	Arb 3311	
	5" @ 3311	
	Pump 300 pot.	
	TD 3314	
	Grav. 41.8	

COMPLETED

KANSAS

Pool Name SilicaMap No. 46 Sec. 30 Twp. 19 R. 10WWell No. 1 E. NothMouser Drlg. Company**FIRST REPORT** ContractorNE SE SE

## SECTION PLAT

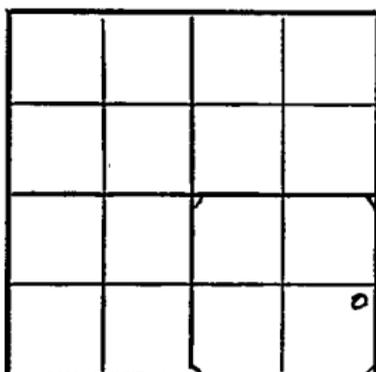

\_\_\_\_\_ Ft. from N. Line

990 Ft. from S. Line330 Ft. from E. Line

\_\_\_\_\_ Ft. from W. Line

Rice County

Location \_\_\_\_\_

Rig up \_\_\_\_\_

Drilling and Remarks:

8" - 156 WOC

## RECORD

Cased \_\_\_\_\_ in., \_\_\_\_\_ ft.

Sand \_\_\_\_\_

Gas \_\_\_\_\_

Oil \_\_\_\_\_

Total Depth \_\_\_\_\_

## PRODUCTION

1st 24 hrs. Nat. \_\_\_\_\_

1st 24 hrs. after shot \_\_\_\_\_

Gas \_\_\_\_\_ Cu. Ft.

Dry Hole \_\_\_\_\_

Abandoned \_\_\_\_\_

Date

AUG 23 1944

19

S. J. LEWIS

Scout

Pool Name Silica PoolMap No. 46 Sec. 30 Twp. 19 R. 10WWell No. 1 E. RothMouser Drlg. Company**COMPLETED**

Contractor

NE SE SE

## SECTION PLAT

\_\_\_\_\_ Ft. from N. Line

990

\_\_\_\_\_ Ft. from S. Line

330

\_\_\_\_\_ Ft. from E. Line

\_\_\_\_\_ Ft. from W. Line


Rice County

Location \_\_\_\_\_

Rig up \_\_\_\_\_

Drilling and Remarks:

CR 33115" @ 3311Pump 800 ft.H. E. Ge

## RECORD:

Cased \_\_\_\_\_ in., \_\_\_\_\_ ft.

Sand \_\_\_\_\_

Gas \_\_\_\_\_

Oil \_\_\_\_\_

Total Depth 3314

## PRODUCTION

1st 24 hrs. Nat. \_\_\_\_\_

1st 24 hrs. after shot \_\_\_\_\_

Gas \_\_\_\_\_ Cu. Ft.

Dry Hole \_\_\_\_\_

Abandoned \_\_\_\_\_

Date

OCT 4 1944 19S. J. LEWIS Scout