

Rice

KANSAS


Form 51—5M—11-38—Palace

Section 30 Township 19 Range 9-W

Well No. 1 Barngrover

Company Gulf

NORTH Wildcat

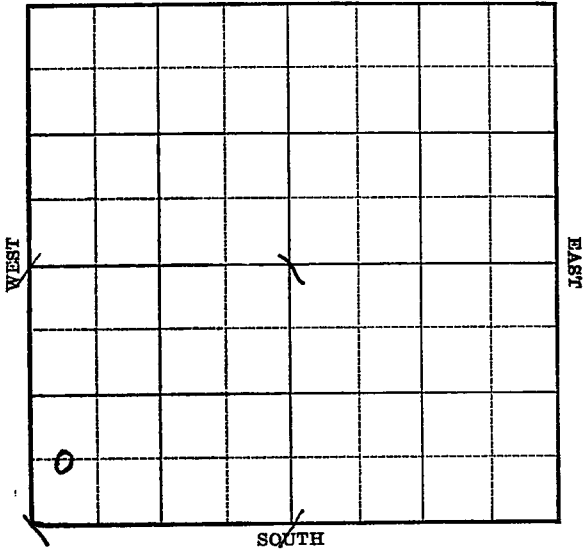

KANSAS

Rice

Sec. 30 Twp. 19 R. 9-WWell No. #1 Barngrover FarmGulf

Company

(Wildcat)


\_\_\_\_\_ Ft. from N. Line

660 Ft. from S. Line

\_\_\_\_\_ Ft. from E. Line

330 Ft. from W. Line

Elev. 1732'

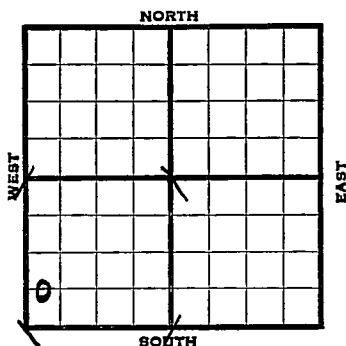

| 1939 | REPORT                        |
|------|-------------------------------|
| 3/15 | Location                      |
| 3/24 | B.R.R.                        |
| 3/31 | 10" - 190' Drlg. 1880'        |
| 4/7  | Lans. 2943' S. O. 3018'       |
|      | Drlg. 3238'                   |
| 4/14 | Cong. 3255' Arb. 3269'        |
|      | S. O. 3280-82' T.D. 3284'     |
|      | 7" - 3280' Drlg. plug.        |
| 4/21 | T.D. 3284' 2500' oil 5 hrs.   |
|      | Total 3200' oil. Swab 224 oil |
|      | in 9 hours.                   |
| 4/26 | 7" - 3280'                    |
|      | Arb. 3269'                    |
|      | T. D. 3284'                   |
|      | 2000 aci d.                   |
|      | Pump 441 bbls. 8 hours.       |
|      | Potential 1322 bbls.          |
|      | COMPLETED                     |

Rice

KANSAS

Map No. 49 Sec. 30 Twp. 19 R. 9WWell No. 1 Barngrover

Gulf

Company

Contractor

## FIRST REPORT

C W L SW SW


\_\_\_\_\_ Ft. from N. Line

660 Ft. from S. Line

\_\_\_\_\_ Ft. from E. Line

330 Ft. from W. Line

## SECTION PLAT

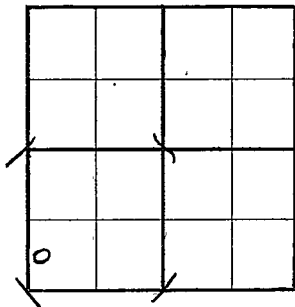

WILDCAT

Location X

Rig up \_\_\_\_\_

Drilling and Remarks:

## RECORD

Cased \_\_\_\_\_ in., \_\_\_\_\_ ft.

Sand \_\_\_\_\_

Gas \_\_\_\_\_

Oil \_\_\_\_\_

Total Depth \_\_\_\_\_

## PRODUCTION

1st 24 hrs. Nat. \_\_\_\_\_

1st 24 hrs. after shot \_\_\_\_\_

Gas \_\_\_\_\_ Cu. Ft.

Dry Hole \_\_\_\_\_

Abandoned \_\_\_\_\_

Date

MAR 15 1939

19

H. D. Hatfield

Scout

Rice

KANSAS

Map No. 49 Sec. 30 Twp. 19 R. 9WWell No. 1 Barngrover

Gulf

Company

Contractor

**COMPLETED**

C W L SW SW

## SECTION PLAT

|   |  |  |  |
|---|--|--|--|
|   |  |  |  |
|   |  |  |  |
|   |  |  |  |
| 0 |  |  |  |

         Ft. from N. Line660 Ft. from S. Line         Ft. from E. Line330 Ft. from W. Line

WILDCAT

Location                         Rig up                         

Drilling and Remarks:

*2000 Acid**P-441/8**Pot 1322*

## RECORD

Cased 7 in., 3280 ft.Sand Arb 3269Gas                         Oil                         Total Depth 3284

## PRODUCTION

1st 24 hrs. Nat.                         1st 24 hrs. after shot                         Gas                          Cu. Ft.Dry Hole                         Abandoned                         

Date

APR 26 1939 19

H. D. Hatfield Scout