


Section 30 Township 19 Range 9-W

Well No. #1 Handy

Company C. H. Weaver

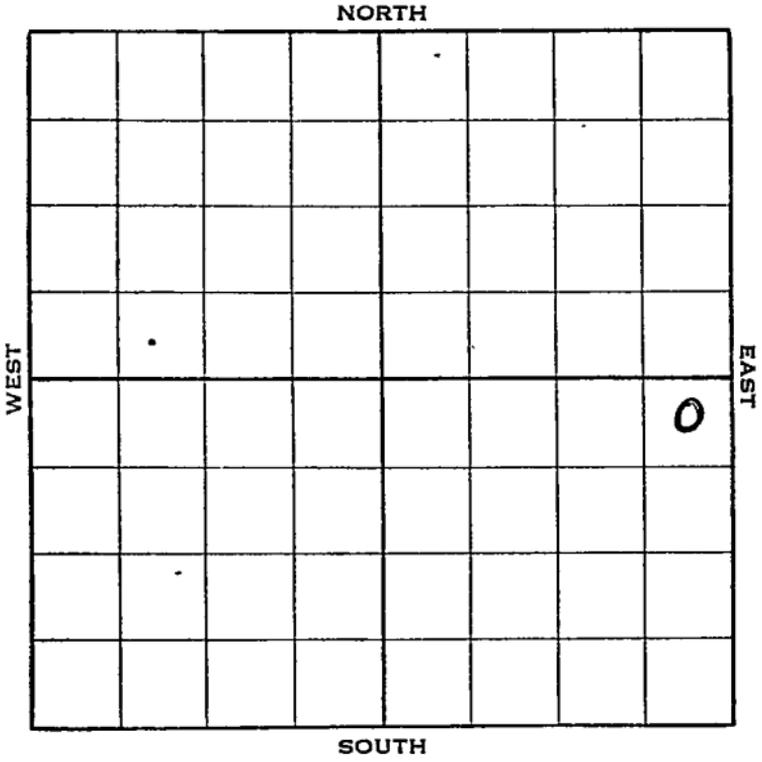

Sec. 30 Twp. 19 R. 9-~~W~~

Well No. #1 Handy Farm

C. H. Weaver Company


330 Ft. from N. Line

_____ Ft. from S. Line

330 Ft. from E. Line

_____ Ft. from W. Line

Elev. 1720

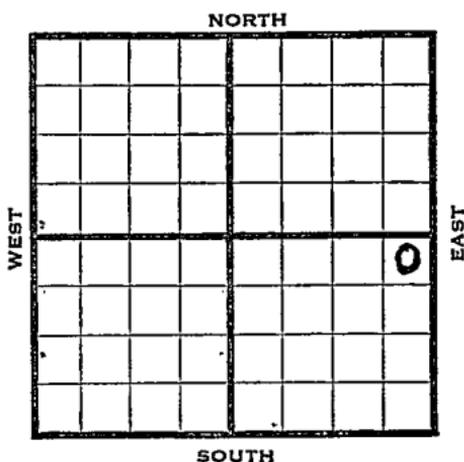

1938	REPORT
4/6	C. R.
4/15	R. U.
4/22	20" @ 18'. 15" @ 131'. Anhy 325'. 12" @ 780'. Drlg. 830'.
4/29	10" @ 1830'. Drlg. 2050'.
5/6	8" @ 2240'. Drlg. 2850'.
5/12	K.C. 2921'. 6" @ 2936'. S.O. & W. 3115-25- & 3139-45'. Cong. 3206'. Arb. 3234'. S.O. 3250-75'. Rng. 5".
5/20	5" @ 3253'. T.D. 3275'. 350' oil S/S.W. Will acidize.
5/27	P.B. 3274'. 3000 acid. Swab 12 oil 3 hrs. No water. 4000 acid.
6/3	" " " " "
	OVER

1938

6/8

5" @ 3253'.

Arb. 3234'.

T.D. 3275'.

P. B. 3274'.

7000 acid.

Potential 228 bbls.

Est. $3\frac{1}{2}\%$ water.

COMPLETED

Map No. 49 Sec. 30 Twp. 19 R. 9WWell No. 1 HandyC. H. Weaver Company

Contractor

FIRST REPORT

SECTION PLAT

NE SE

330 Ft. from N. Line

Ft. from S. Line

330 Ft. from E. Line

Ft. from W. Line

			0

Location _____

Rig up _____

Drilling and Remarks:

CR

RECORD

Cased _____ in., _____ ft.

Sand _____

Gas _____

Oil _____

Total Depth _____

PRODUCTION

1st 24 hrs. Nat. _____

1st 24 hrs. after shot _____

Gas _____ Cu. Ft.

Dry Hole _____

Abandoned _____

Date

APR 6 - 1938 19

H. D. Hatfield Scout

Handwritten scribbles and lines, possibly representing a map or diagram.

Ray

Returned	
Cards	<i>Paul</i>
Trails	<i>Joe</i>
France Map	<i>Ray</i>
Scarborough Map	<i>Ray</i>
Moody Map	<i>Ray</i>
Scarborough Plat Book	
Moody Plat Book	

Map No. 49 Sec. 30 Twp. 19 R. 9W

Well No. 1 Handy

C. H. Weaver Company

Contractor

COMPLETED

SECTION PLAT

NE SE

330 Ft. from N. Line

_____ Ft. from S. Line

330 Ft. from E. Line

_____ Ft. from W. Line

			0

Location _____

Rig up _____

Drilling and Remarks:

P.B. 3274.

7000 Acid

POT 228

EST 3 1/2 % w/t

RECORD

Cased 5 in., 3253 ft.

Sand Arb 3234

Gas _____

Oil _____

Total Depth 3275

PRODUCTION

1st 24 hrs. Nat. _____

1st 24 hrs. after shot. _____

Gas _____ Cu. Ft.

Dry Hole _____

Abandoned _____


Date

JUN 8 - 1938

19

H. D. Hatfield

Scout

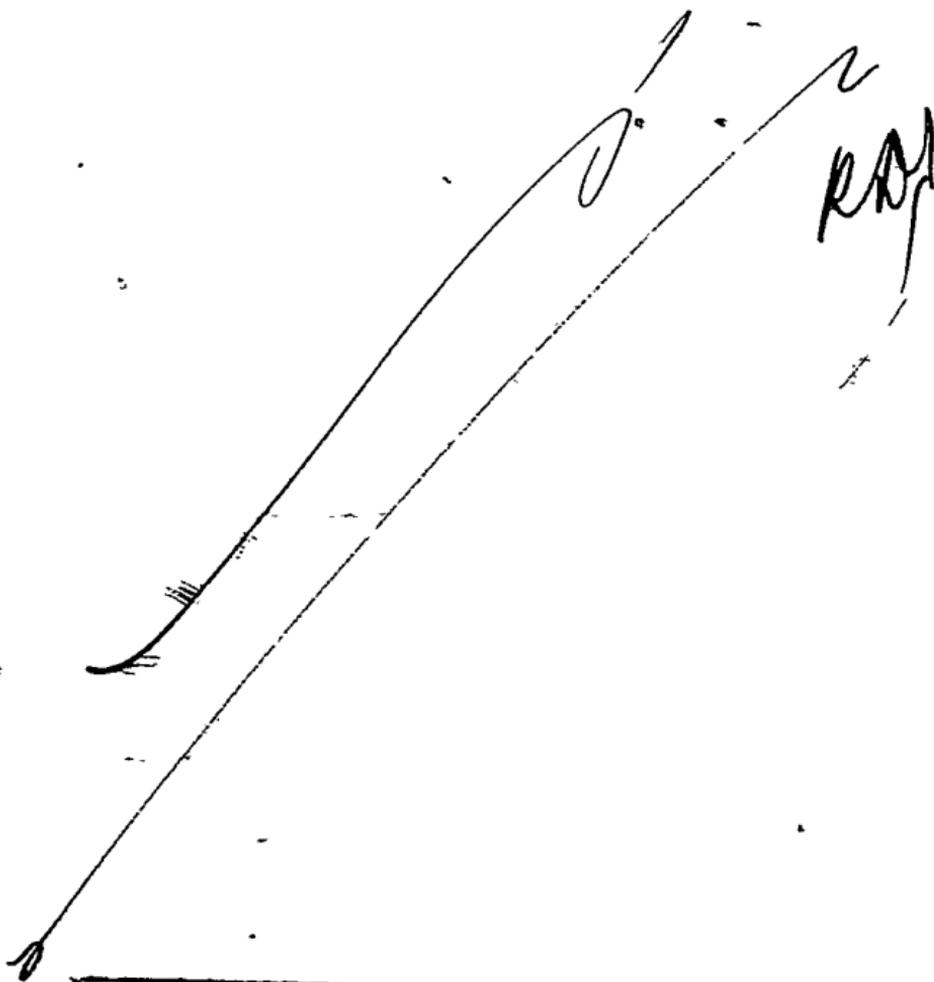

RAA

Returned	_____
Cards	<i>Paul</i>
Tracing	<i>gm</i>
France Map	<i>✓</i>
Scarborough Map	<i>✓</i>
Moody Map	_____
Scarborough Plat Book	_____
Moody Plat Book	_____