


Section 30 Township 19 Range 13 WWell No. # 1 KellyCompany Simon Lebow

NORTH

WEST

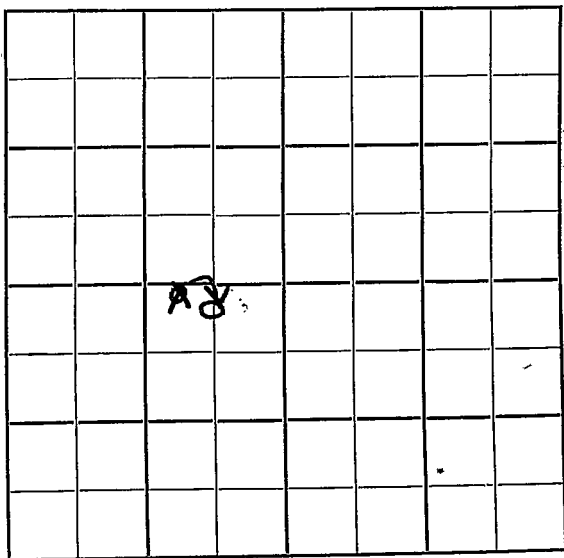

EAST

SOUTH

Barton

KANSAS

Sec. 30 Twp. 19 R. 13W

Well No. #1 Kelly Farm

Simon Lebow Company


Contractor

200
150 Ft. from N. Line

Ft. from S. Line

660
990 Ft. from E. Line

Ft. from W. Line

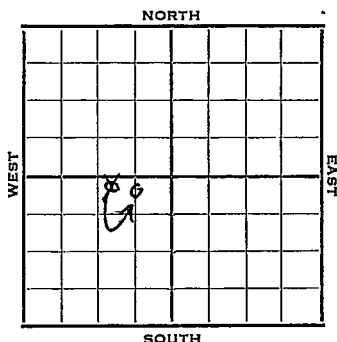

~~NW NE SW~~
:C N L N E S W

1952

Elev. 1863'

REPORT

4/30
5/7

RUR
8" @ 781' Anhy 776'
Drlg. 2798'

5/14
5/21

Drlg. 3173'
Spud 4-28-52
D & A TD 3505' 8" @ 781'
Anhy 776' Heeb 3098' Tor. 3115'
Br. lime 3197' Lans. 3209'
DST 3211-26 open $\frac{1}{2}$ hr. rec 8' mud
Cong. 3430' Arb. 3497' TD 3505'
D & A

ABANDONED

County **Barton** State **Kansas**

Sec. **30** (Blk. Twp.) **19** (Sur. Rge.) **13N** Map No.

Operator **Simon Lebow**

Well No. **1** Farm **Kelly**

Elev.	Location	NW	NE	SW
-------	----------	----	----	----

150 Ft. From **N** Line **SW**

990 Ft. From E Line Quarter

1st. Report APR 30 1952

Completion

Remarks

Spudding Date

Drlg. Data

483

J. G. McGEHEE

Map No. _____ Sec. 30 Twp. 19 R. 13WWell No. 1 KellySimon Lebow Company

Contractor


C N L NE SW200 Ft. from N. Line

_____ Ft. from S. Line

660 Ft. from E. Line

_____ Ft. from W. Line

SECTION PLAT

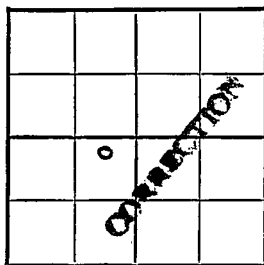Barton County

Location _____

Rig up _____

Drilling and Remarks:

Reported

NW NE SW

RECORD.

Cased _____ in., _____ ft.

Sand _____

Gas _____

Oil _____

Total Depth _____

PRODUCTION

1st 24 hrs. Nat. _____

1st 24 hrs. after shot _____

Gas _____ Cu. Ft.

Dry Hole _____

Abandoned _____

Date

MAY 7 1952J. G. McGEHEE19

Scout

County	Barton			State	Kansas
Sec.	30	(Blk.) Twp.)	19	(Sur.) Rge.)	13W Map No.

Operator Simon Lebow

Well No. 1 Farm Kelly

Elev.	1863	Location	C N L NE SW
-------	------	----------	-------------

ABANDONED

○

200 Ft. From N Line SW

660 Ft. From E Line Quarter

1st. Report

Completion MAY 21 1952

Remarks.

Spudding Date 4-28-52

Drlg. Data D & A TD 3505

8" @781 Anhy 776 Heeb. 3098

Tor. 3115 Br. lime 3197 Lans. 3209

DST 3211-26 open $\frac{1}{2}$ hr. Rec. 8' mud

Cong. 3430 Arb. 3497 TD 3505

D & A

J. G. McGEHEE