


Section 30 Township 19 Range 13 W

Well No. # 1 Warner

Company G-M-R Oil

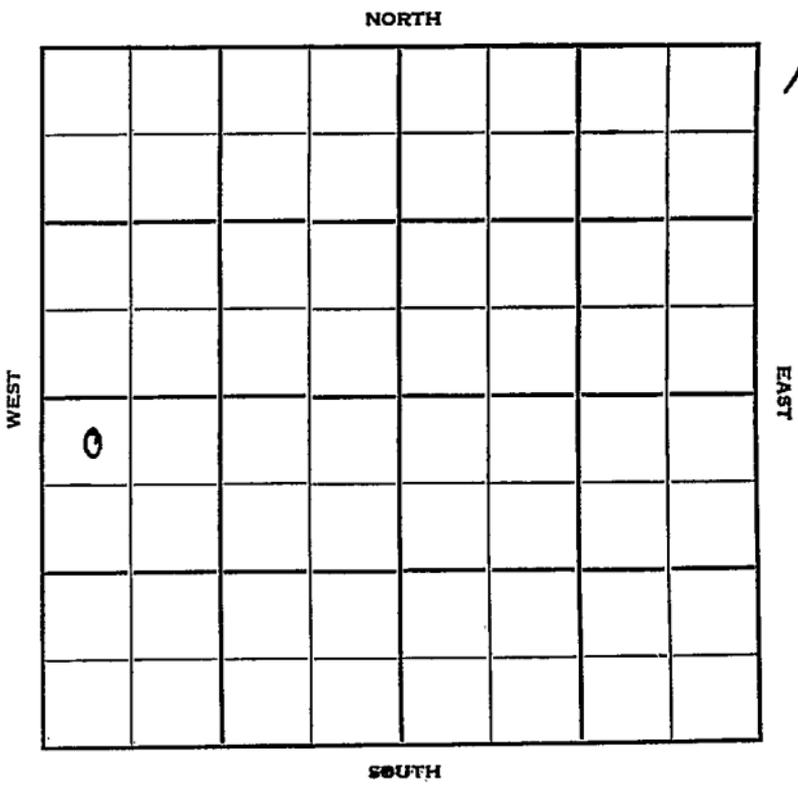

Barton

**KANSAS**

Sec. 30 Twp. 19 R. 13W

Well No. #1 Warner Farm

G-M-R Oil Company

Contractor


SW Great Bend Pool

330' Ft. from N. Line

..... Ft. from S. Line

..... Ft. from E. Line

330' Ft. from W. Line

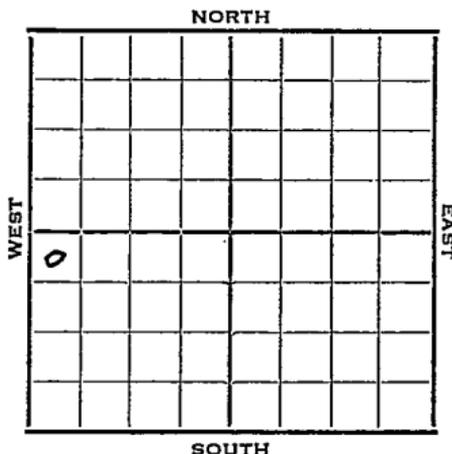

NW NW SW

1952 Elev. 1865' REPORT

3/19 Anhy 770  
8" @ 782  
Drlg. 1865'

3/25 Heeb 3088' Br. Li 3185' Lans. 3198'  
DST 3200-3208' failed.  
DST 3202-26, 1 hr, 30' 0 & GCM  
Drlg. 3250'

4/1 DST 3314-28, 1/2 hr, 60' 0 & GCM, 840#  
DST 3338-46, 45 mins, 120' SO & GCM  
840# Cong. 3452' Arb. 3483'  
TD 3489' 4" @ 3485'

4/9 DP DD to 3508 TD 6 BWPB PB 3450  
42/3320-44 2000 A PB 3370  
24/3336-44 900 A 18/3320-26 1100 A  
S/38 BO 1st 45 mins S/26 BO 1/2 hr.  
Set plug 3215 21/3202-09  
2000 A S/2 BO 1st hr.  
S/1 BOPH for 3 hrs. DP 3370  
S/35 BO 1/2 hr. POP

4/23 NR  
4/30 "  
5/7 "  
5/13 Spud 3-13-52 Oil Well TD 3508  
Anhy 770' 8" @ 782' Heeb. 3088  
Br Li 3185' Lans. 3198  
DST 3200-3208 failed

**OVER**





1952

5/14

~~Spdx 34352~~  
~~Oil Well TD 3508'~~

~~Any of~~

DST 3202-26 open 1 hr. rec. 30'

O&GCM DST 3314-28 open  $\frac{1}{2}$  hr. rec.

60' O&GCM DST 3338-46 open 45 min.

Rec. 120' SO&GCM Cong. 3452'

Arb. 3483 TD 3489 4" @ 3485

DD 3508 6 bwph PB 3450 42/ 3320-44

2000 A PB 3370 24/ 3336-44 900 A

18/ 3320-26 1100 A S/ 38 bo 45 min.

S/ 26 bo  $\frac{1}{2}$  hr. SP 3215 21/ 3202-09

2000 A S/ 2 boph DP 3370 S/ 35 bo

$\frac{1}{2}$  hr. DP to 3370' S/ 35 bo  $\frac{1}{2}$  hr.

Comp. 111 bopd 26% wtr.

**COMPLETED**