
FORM 51 25M 8-50 WESTERN Barton

KANSAS

Section 30 Township 19 Range 12 W

Well No. # 1 Harris (C)

Company National Assoc.

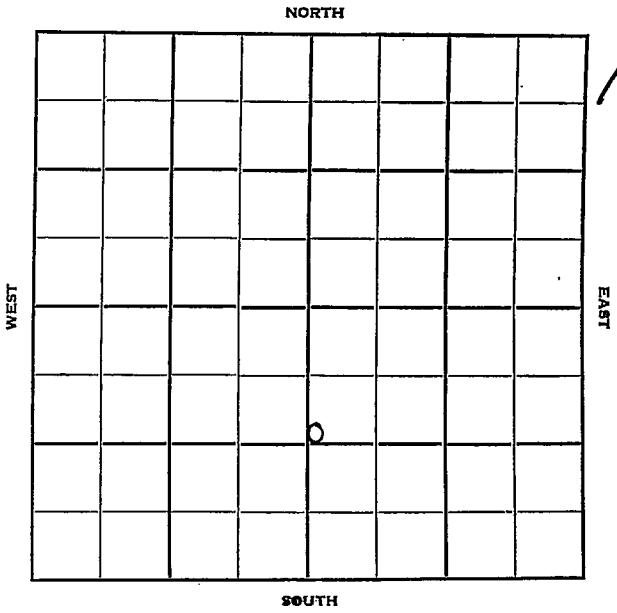

10

FORM 252-B
10M 11-50 PETROL

Barton KANSAS

Sec. 30 Twp. 19 R. 12W

Well No. #1 Harris (C) Farm

National Assoc. Company

Hartman - Contr. Contractor

Ft. Zarah Pool


1200' Ft. from N. Line

Ft. from S. Line

Ft. from E. Line

100' Ft. from W. Line

SW NW SE

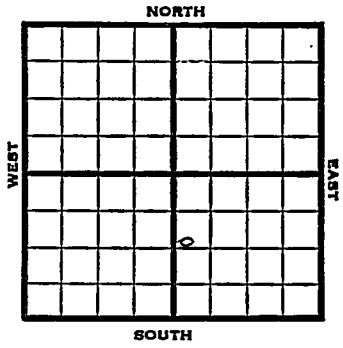

1951	Elev. 1827' REPORT
7/11	Spud 7-1-51 8" @ 200'
8/29	Spud 7-1-51 Oil well TD 3387' 8" @ 200 Lans. 3127' B KC 3360'. DST 2913-33 open ½ hr. rec 60' mud Arb. 3382' TD 3387' 5" @ 3384 48/3147-57 1000 A F/76 BOPH Comp. BHB 1143 BOPD COMPLETED

FORM 275 FOR SALE BY KANSAS BLUE PRINT CO.


County Barton State Kansas

Sec. 30 (Blk. / Twp.) 19 (Sur. / Rge.) 12W Map No.

Operator National Assoc.

Well No. 1 Farm Harris (C)

Elev. Location SW NW SE

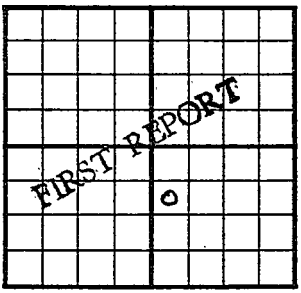

1200 Ft. From N Line SE

100 Ft. From W Line Quarter

1st. Report JUL 11 1951

Completion

Remarks

Hartman - Contr.

Spudding Date 7-1-51

Drlg. Data Ft. Zarah - pool

8" @ 200'

J. E. TYRA

FORM 275 FOR SALE BY KANSAS BLUE PRINT CO.


County Barton State Kansas

Sec. 30 (Blk. Twp.) 19 (Sur. Rge.) 12W Map No.

Operator National Assoc. Pet.

Well No. 1 Farm Harris "C"

Elev. 1827 Location SW NW SE

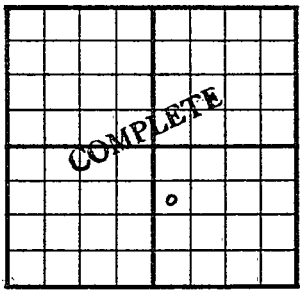

1200 Ft. From N Line SE

100 Ft. From W Line Quarter

1st. Report

Completion AUG 2 9 1951

Remarks Ft. Zarah Pool

Hartman - Contr.

Spudding Date 7-1-51

Drlg. Data Oil well TD 3387

8" @ 200 Lans. 3127 B KC 3360

DST 2913-33 open ½ hr. Rec. 60' mud

Arb. 3382 TD 3387 5" @ 3384 48/ 3147-57

1000 A F/ 76 boph Comp. BHB 1143 bopd

J E. TYRA