


Section 30 Township 19 Range 12W

Well No. #1 Harris "B"

Company National Assoc. Pet.

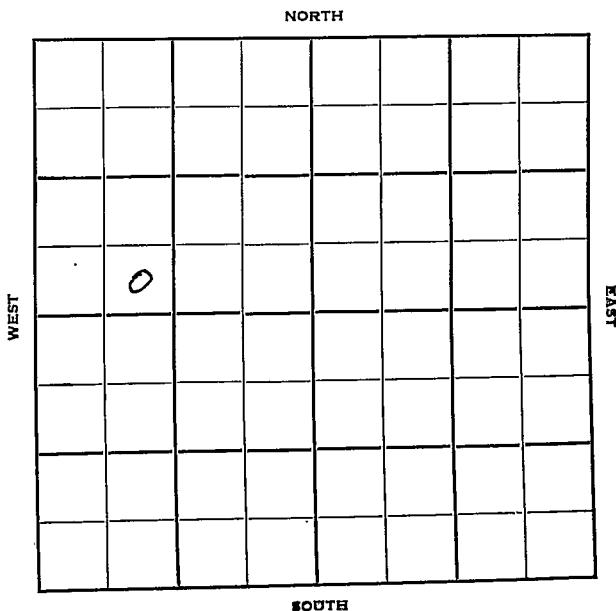

Barton

KANSAS

Sec. 30 Twp. 19 R. 12W ✓

Well No. #1 Harris "B" ✓ Farm

National Assoc. Pet. Company

Hartman- Contr. Contractor  
Ft. Zarah Pool


         Ft. from N. Line

330' Ft. from S. Line

         Ft. from E. Line

990' Ft. from W. Line

SE SW NW

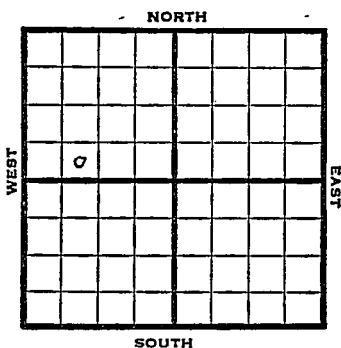

1951

Elev. 1830'

REPORT

10/24

Spud 10-16-51

8" @ 186

Anhy 660

Drlg. 2960'

12/5

Spud 10-16-51

Oil Well TD 3407

8" @ 186

Anhy 660 Heeb. 3009

Ians. 3139

DST 3140-81 open 1 hr.

Rec. 115' mud

DST 3191-3235 open 1 hr.

Rec. 49' mud & SW

DST 3305-72 open 1 hr.

Rec. 77' Oil & GCM

DST 3302-28 open 1 hr.

Rec. 7' GCM

DST 3392-3402 open 1 hr.

Rec. 9' mud

Arb. 3389

DST 3393-3405 open 1 hr.

Rec. 200' mud TD 3407

5" @ 3403 CO to 3407 500A

9 GO 9 GWPB 16 hr. 500 A

S/ 40 BO 45 BWPB

Comp. 41 BOPD 83 % wtr.

**COMPLETED**

County Barton State Kansas

Sec. 30 (Blk. Twp.) 19 (Sur. Rge.) 12W Map No.

Operator National Assoc. Pet.

Well No. 1 Farm Harris "B"

Elev. Location SE SW NW


330 Ft. From S Line NW

990 Ft. From W Line Quarter

Ist. Report OCT 24 1951

Completion

Remarks

Hartman - Contr.

Spudding Date 10-16-51

Drlg. Data Ft. Zarah Pool

8" @ 186 Anhy 660 drlg. 2960

County Barton State KansasSec. 30 (Blk. Twp.) 19 (Sur. Rge.) 12W Map No.Operator National Assoc. Pet.Well No. 1 Farm Harris "B"Elev. 1830 Location SE SW NW


330 Ft. From S Line NW990 Ft. From W Line Quarter

1st. Report

Completion DEC 5 1951Remarks Ft. Zarah PoolHartman - Contr.Spudding Date 10-16-51Drlg. Data Oilwell TD 34078" @ 186 Anhy 660 Heeb. 3009Lans. 3139 DST 3140-81 open 1 hr.Rec. 115' mud DST 3191-3235 open 1 hr.Rec. 49' mud & Sw DST 3305-72 open 1 hr.Rec. 77' oil & gcm DST 3302-28 open 1 hr.Rec. 7' gcm DST 3393-3402 open 1 hr.Rec. 9' mud Arb. 3389 DST 3393-3405open 1 hr. Rec. 200' mud TD 34075" @ 3403 CO to 3407 500 A9 go 9 gwph 16 hr. 500 A S/ 40 bo45 bwph Comp. 41bopd 83 % water

J. E. TYRA