

Section 30 Township 19 Range 12 W


Well No. # 2 Welsh

Company Lion Oil

NORTH

WEST

EAST

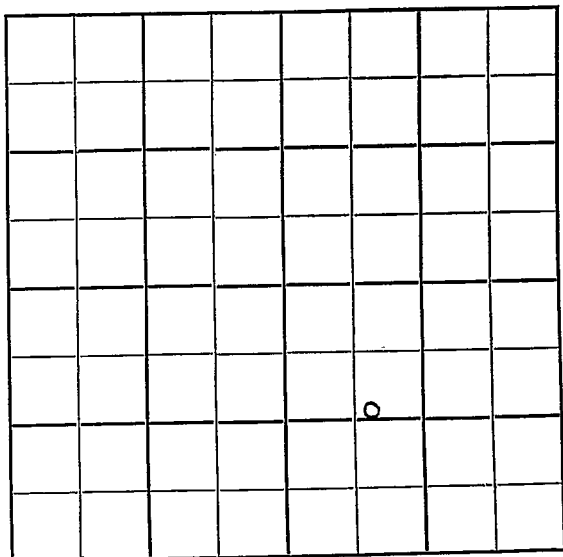

SOUTH

10

Sec. 30 Twp. 19 R. 12 W ✓

Well No. # 2 Welsh Farm

Lion Oil Company

Rine Drlg. Contractor

Fort Zarah Pool


1230 Ft. from N. Line

\_\_\_\_\_ Ft. from S. Line

\_\_\_\_\_ Ft. from E. Line

800 Ft. from W. Line

C S L SE NW SE

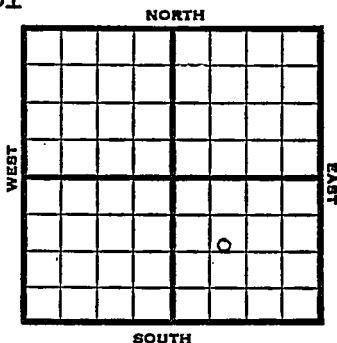

1951

Elev. 1826'

REPORT

5/16 Spud 5-13-51  
9" @ 187  
Drlg. 500'

6/13 Spud 5-13-51  
Oil well TD 3381' 8" @ 187  
Heeb 2988' Br. lime 3104'  
Lans. 3120'  
DST 3121-90 open 4 min. rec 90' mud  
Cong. 3365' Arb. 3376-81'  
5" @ 3377 CO to 3324 2 1/4 / 3271-79  
1000 A B/4 BFPH 10% oil SP 3200  
2 1/4 / 3171-79 2 1/4 / 3142-50  
23 / 3127-35 23 / 3123-31 F/65 BO  
12 hr. 2000 A F/35 BOPH  
Comp. 346 BOPD

**COMPLETED**

County Barton State Kansas

Sec. 30 (Blk. 19 (Sur. Rge.) 12W Map No.

Operator Lion Oil

Well No. 2 Farm Welsh

Elev. \_\_\_\_\_ Location C S 1, SE NW SE


FIRST REPORT

1230  
1330 From N Line SE  
800 Ft. From W Line Quarter

Ist. Report MAY 16 1951

Completion \_\_\_\_\_

Remarks \_\_\_\_\_

Rine Drlg. - Contr.

Spudding Date 5-13-51

Drlg. Data Fort Zarah Pool

9" @ 187 drlg. 500

