


Section 30 Township 19 Range 12W

Well No. 3 Harris #611 "A"

Company National Assoc. Pet.

NORTH

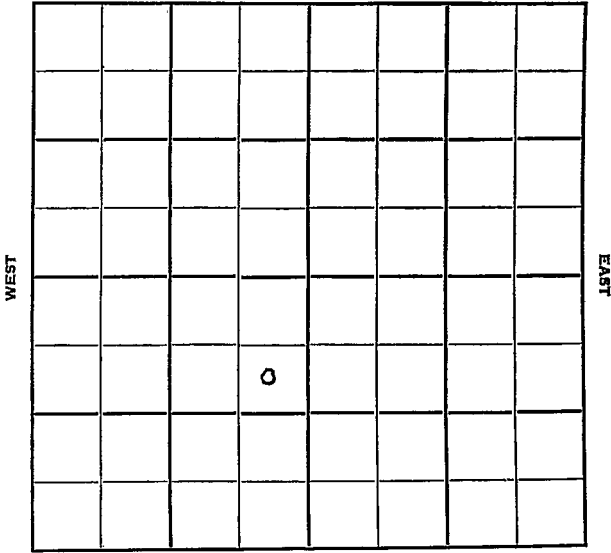

WEST

EAST

SOUTH

Sec. 30 Twp. Barton 19N R. 12W ✓

Well No. #3 Harris "A" Farm

National Assoc. Pet. Company

Hartman- Contr. Contractor

Fort Zarah Pool


990' Ft. from N. Line

_____ Ft. from S. Line

330' Ft. from E. Line

_____ Ft. from W. Line

SE NE SW

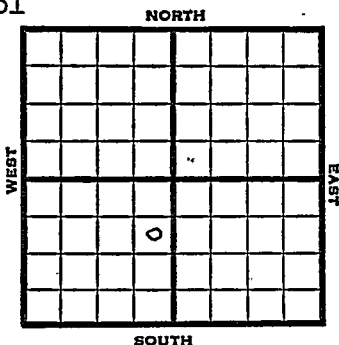

1951

Elev. 1827' REPORT

8/1

Spud 7-28-51
8" @ 190
Anhy 638-62
Drlg. 1928'

9/5

Spud 7-28-51
Oil Well TD 3389
8" @ 190
Anhy 638-62 Top. 2763
Heeb. 2998 Br Lime 3114
Lans. 3129
DST 3132-67 opn 10 min. Rec. 74' gcm
114 oil 60' mco
DST 3174-3215 opn 1 hr Rec. 20' mud
Arb. 3386 TD 3389
5" @ 3386 28/3328-58 S/10 boph
2000 A Comp. BHB 1355 bopd

COMPLETED

County Barton State Kansas

Sec. 30 (Blk. 19) (Sur. 12W) (Twp. 19) (Rge. 12W) Map No.

Operator National Assoc. Pet.

Well No. 3 Farm Harris "G"

Elev. _____ Location SE NE SW

FIRST REPORT

990 Ft. From N Line SW

330 Ft. From E Line Quarter

Ist. Report AUG 1 1951

Completion _____

Remarks _____

Hartman - Contr.

Spudding Date 7-28-51

Drlg. Data Fort Zarah Pool

8" @ 190 Anhy 638-62 drlg. 1928

J. E. TYRA

Map No. _____ Sec. 30 Twp. 19 R. 12WWell No. 3 Harris "A"_____
National Assoc. Pet. _____ Company_____
Contractor

SE NE SW

SECTION PLAT

990 Ft. from N. Line

_____ Ft. from S. Line

330 Ft. from E. Line

_____ Ft. from W. Line

	CORRECTION		
	0		

Barton County

Location _____

Rig up _____

Drilling and Remarks:

Reported
#3 Harris "C"

RECORD

Cased _____ in., _____ ft.

Sand _____

Gas _____

Oil _____

Total Depth _____

PRODUCTION

1st 24 hrs. Nat. _____

1st 24 hrs. after shot _____

Gas _____ Cu. Ft.

Dry Hole _____

Abandoned _____

Date

AUG 8 1950 19J. E. TYRA Scout

