


Section 30 Township 19 Range 12W

Well No. #3 Harris "C"

Company National Assoc. Pet.

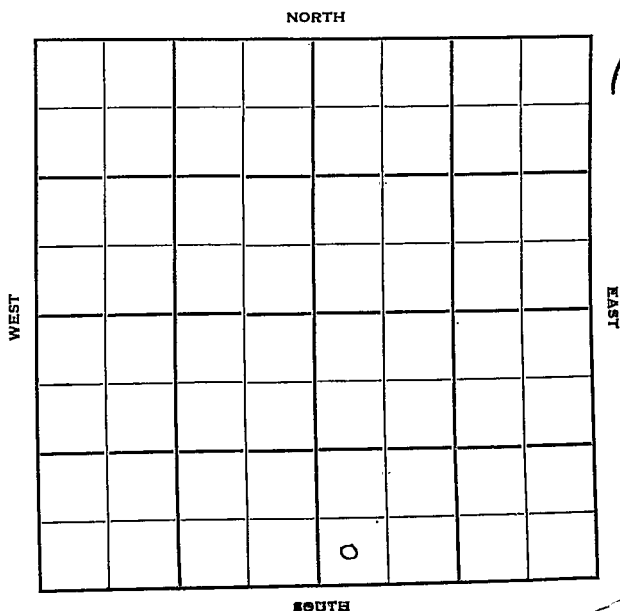

Barton

KANSAS

Sec. 30 Twp. 19 R. 12 W

Well No. # 3 Harris "C" Farm

National Assoc. Pet. Company

H & H Drlg. Contractor

Ft. Zarah Pool


 Ft. from N. Line

330 Ft. from S. Line

 Ft. from E. Line

330 Ft. from W. Line

SW SW SE

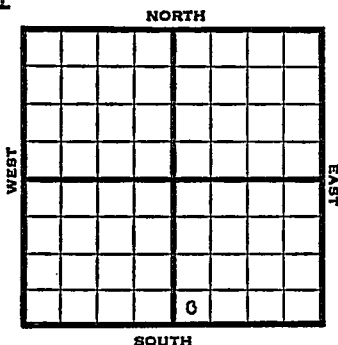

1951

Elev. 1827' REPORT

8/8

Location

12/5

Spud 9-13-51
 Oil Well TD 3390
 8" @ 193
 Anhy 643-658 Lans. 3097
 DST 3100-3162 open 5 min.
 Rec. 313' O&GCM
 DST 3168-3224 open 5 min.
 Rec. 150' O&GCM
 Arb. 3360
 DST 3354-3364 Rec. 5' mud
 TD 3365 5" @ 3361 DD 3390
 PB 3340 12/ 3320-23 SSO
 18/ 3293-96 FU 1600' oil 12 hr.
 1000 A F/ 9 BOPH
 Comp. 199 BOPD

COMPLETED

