


Section 30 Township 19 Range 12W

Well No. #5 Harris "A"

Company National Assoc. Pet.

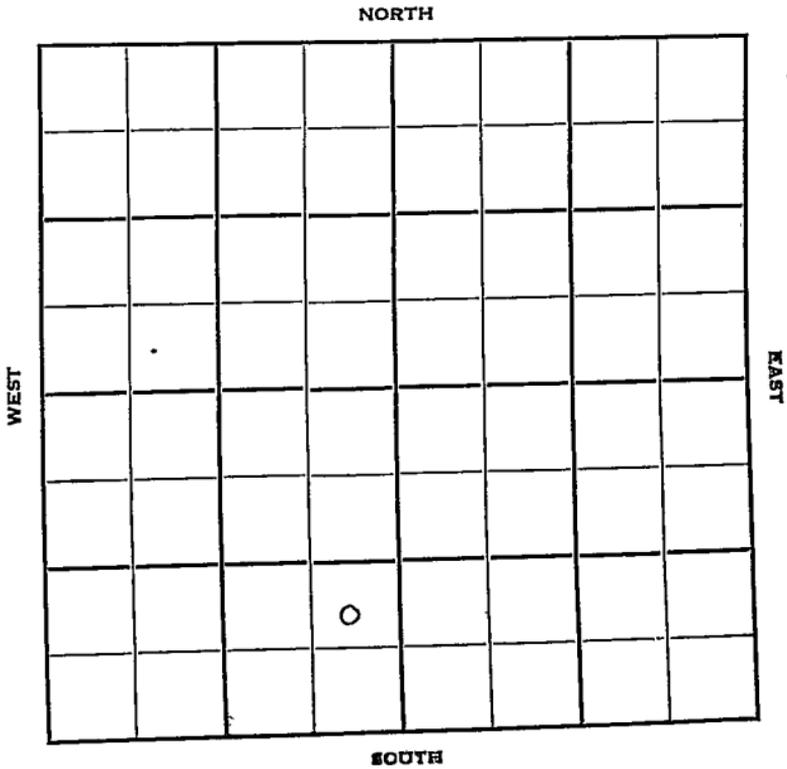

Barton

KANSAS

Sec. 30

Twp.

19

R.

12W

Well No. #5 Harris "A" Farm

National Assoc, Pet. Company

H & H-Drlg. - Contr. Contractor


Fort Zarah Pool

Ft. from N. Line

990' Ft. from S. Line

330' Ft. from E. Line

Ft. from W. Line

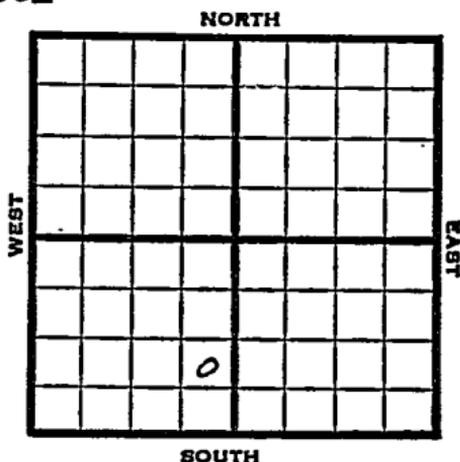

NE SE SW

1951

Elev. 1828' REPORT

8/15

Spud 8-10-51
8" @ 191
Anhy 642
Drlg. 2000'

9/19

Spd 8-10-51
Oil Well TD 3384
8" @ 191
Anhy 642 Lans. 3144
Arb. 3382
5" @ 3382
DST 3124-56 opn 10 min., gas in 8 min. Rec. 55' gcm 180' mco
DST 3160-3202 opn 1 hr
Rec. 813' sw
DST 3271-3350 opn 1/2 hr Rec. 185'
o & gcsw 42' ocsw GO to 3367
17/3145-49 31/3126-28 s/2 boph
2000 A S/73 bo 1 hr
Comp. draw down pot 2340 bopd

COMPLETED

