

Section 30 Township 19 Range KANSAS 22WWell No. #5 WelshCompany Lion Oil

|  |  |  |  |  |  |  |  |
|--|--|--|--|--|--|--|--|
|  |  |  |  |  |  |  |  |
|  |  |  |  |  |  |  |  |
WEST

EAST

NORTH

SOUTH

9

0

Barton

KANSAS

Sec. 30 Twp. 19 R. 12 W

Well No. # 5 Welsh Farm

Lion Oil Company

Rine Drlg. Contractor

Fort Zarah Pool


1190 Ft. from N. Line

\_\_\_\_\_ Ft. from S. Line

330 Ft. from E. Line

\_\_\_\_\_ Ft. from W. Line

SE NE SE

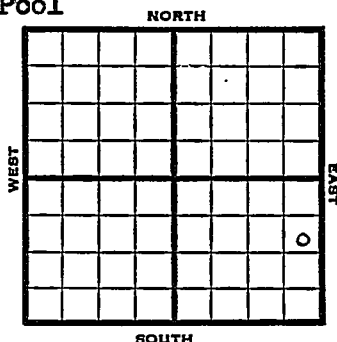


1951 Elev. 1825' REPORT

6/6 9" @ 198  
Drlg. 1210'

6/27 Oil well TD 3393' 9" @ 198  
Heeb 2994' Br. lime 3110'  
Lans. 3126'  
DST 3128-3200 open  $\frac{1}{2}$  hr. rec 110' mud  
Arb. 3391-93' 5" @ 3392  
TD 3393' S/30 BOPH 1000 A  
S/32 BOPH  
Comp. 1873 BOPD

COMPLETED

County Barton State Kansas  
 Sec. 30 (Blk.  
Twp.) 19 (Sur.  
Rge.) 12W Map No.  
 Operator Lion Oil  
 Well No. 5 Farm Welsh  
 Elev. Location SE NE SE

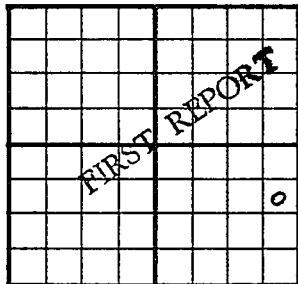


1190 Ft. From N Line SE  
330 Ft. From E Line Quarter  
 Ist. Report JUN 6 1951  
 Completion  
 Remarks  
Rine Drlg. - Contr.  
 Spudding Date

Drlg. Data Fort Zarah Pool  
9" @ 198 drlg. 1210

J. E. TYRA

County Barton State Kansas  
 Sec. 30 (Blk. Twp.) 19 (Sur. Rge.) 12W Map No. \_\_\_\_\_  
 Operator Lion Oil  
 Well No. 5 Farm Welsh  
 Elev. 1825 Location SE NE SE

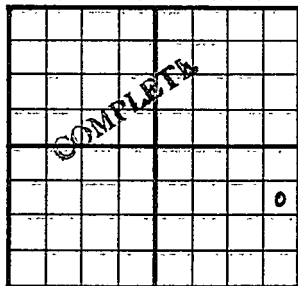

1190 Ft. From N Line SE

330 Ft. From E Line Quarter

1st. Report

Completion JUN 27 1951

Remarks Fort Zarah Pool

Rine Drlg. - Contr.

Spudding Date

Drlg. Data Oil well TD 3393

9" @ 198 Heeb. 2994 Br. lime 3110

Lans. 3126 DST 3128-3200 open  $\frac{1}{2}$  hr.

Rec. 110' mud Arb. 3391-93 5" @ 3392

TD 3393 S/ 30 boph 1000 A S/ 32 boph

Comp. 1873 bopd

J. E. TYRA